



City of Prince George
History Sheet

PID:	006518621
SD/MU:	
WO:	

Civic Address: 3763 Pinewood Ave

Legal Description: Lot: 63 District Lot: 2611 Plan: 27420


Service Type	Diameter (mm)	Material	Invert Elev at main (m)	Invert Elev at property line (m)	Invert Depth at service end (m)	Distance into property (m)	Installation Date
Sanitary	100mm	PVC	-	599.84	2.17	-	February 1981
Water	20mm	Copper	-	-	-	-	January 1981
Storm	N/A	N/A	-	-	-	-	

Service Connection Location				Sanitary (m)	Storm (m)
Distance from downstream San MH	1771	towards upstream San MH	3892	64.98	
Distance from downstream Stm MH	-	towards upstream Stm MH	-		

Power	Size	Communications	Size	Cable	Size	Gas	Size
BC Hydro	-	Telus	-	Shaw	-	FortisBC	-
Underground Service		Underground Service		Underground Service			

Installed by:	QSAVE	Survey Date:	-
Comments:	Sanitary locate confirmed March 2013		

NOT TO SCALE The information contained herein is for internal use only.
 Not to be relied on unless confirmed by site inspection and/or investigation.

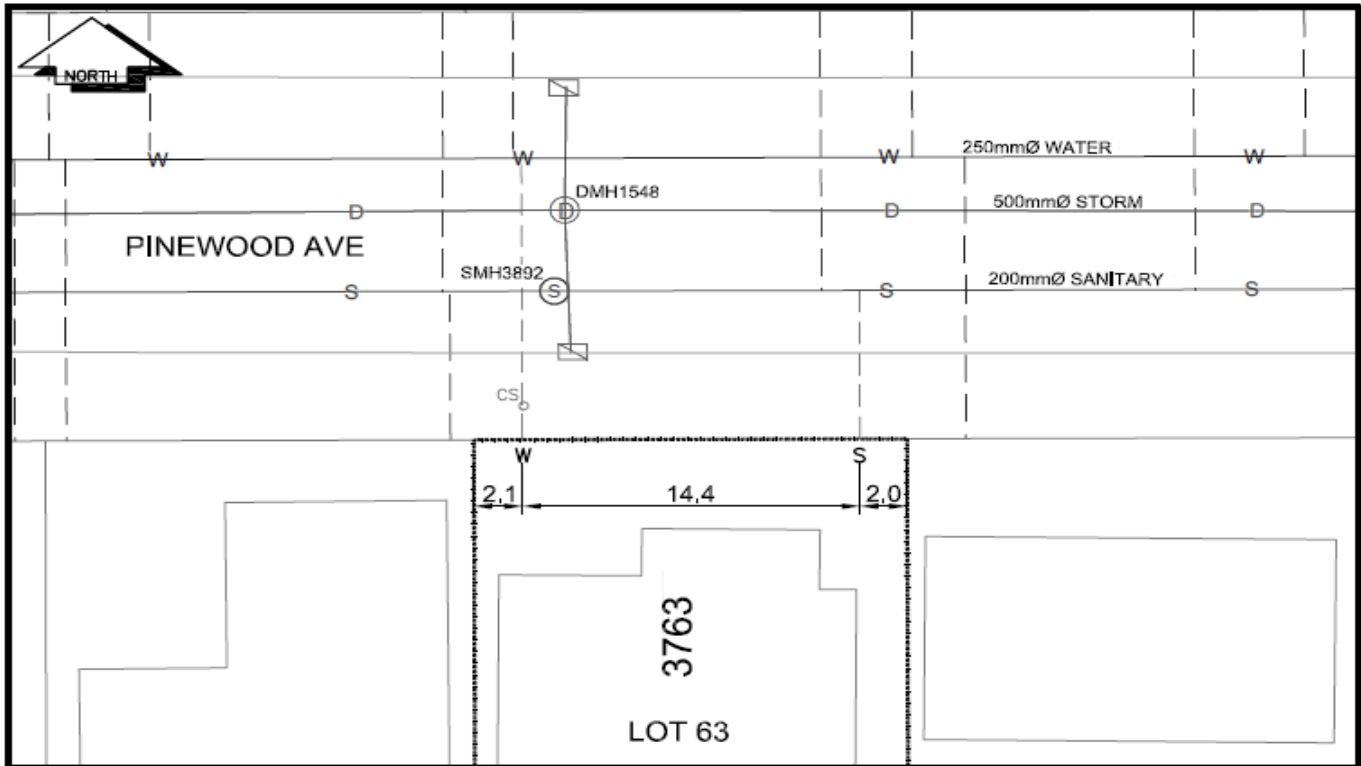

LEGEND:	CS ^o CURB STOP	--- W WATER SERVICE	--- S STORM SERVICE
	CO ^o CLEAN OUT	--- S SANITARY SERVICE	— G — GAS

NOT TO SCALE