

**City of Prince George
HISTORY SHEET**

WILLIS, CUNLIFFE, TAIT & COMPANY LTD
1575 - 5TH. AVE.
PRINCE GEORGE, B.C. V2L 3L9

SHEET NUMBER **No 0322** Roll Number **006518 796**

Legal: LOT'S **72** BLOCK D.L. 2611 & 9265 PLAN **27420**

Address: **3770 JAMES CRT**

Sanitary Connection: # SIZE **100 mm φ** MATERIAL **P.V.C.** INV. **599.10** CONNECTED

Water Connection # SIZE **19 mm φ** MATERIAL **Cu.** METER CONNECTED

Storm Connection: # SIZE MATERIAL INV. CONNECTED

Cash Receipt No's: WATER SANITARY STORM

CURB FROM PROPERTY LINE **5.0 m (Roll)** PAVEMENT WIDTH **10 m**


B.C. HYDRO UNDERGROUND CONNECTION **MID LOT**

B.C. TELEPHONE UNDERGROUND CONNECTION **MID LOT.**

INLAND GAS

Information Sheets: The information contained herein is for internal use only. Not to be relied upon unless confirmed by site inspection and/or investigation.

Comments:

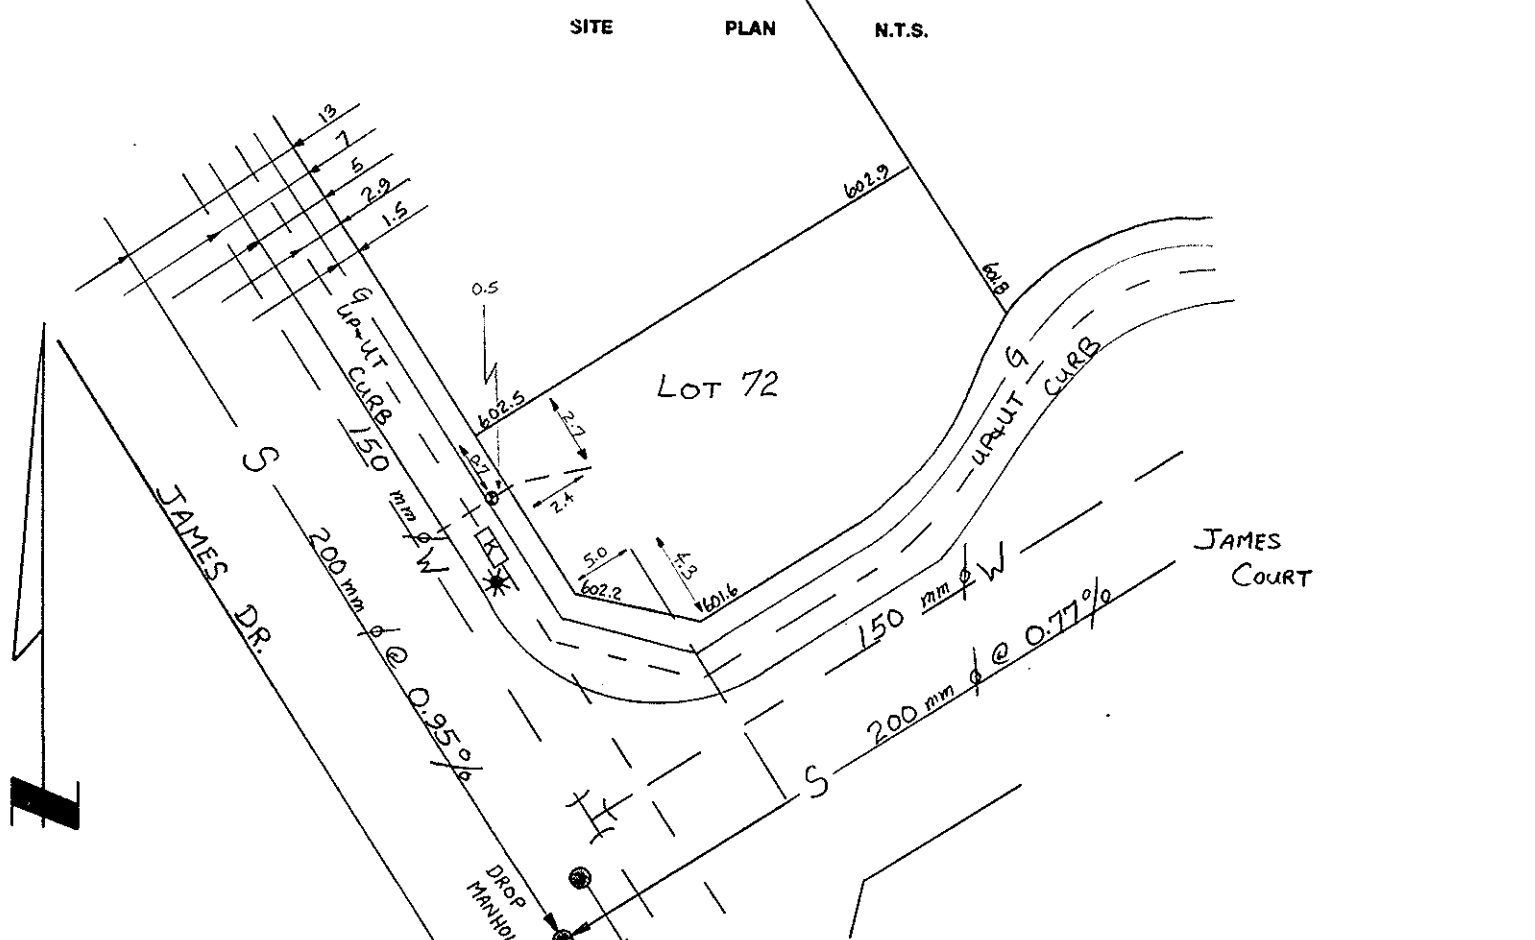

REPORT TO RECORDS

WATER SERVICE INFORMATION

Lot No. _____ Block _____ D.L. _____


Address 3770 JAMES CRT.

Size of Connection 1/2" 3/4" Other _____

Type of Connection Copper Iron

Thaw Wire Yes No

LOCATION SKETCH

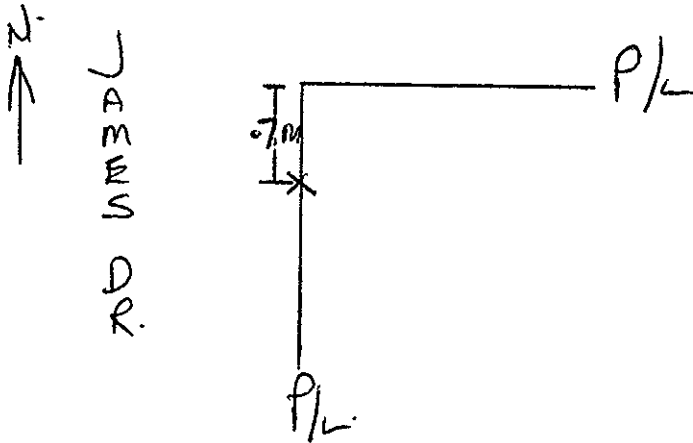

Field Location By L. Puntos Date Jan. 8/01


Checked by: _____

REPORT TO RECORDS

SEWER SERVICE INFORMATION

72-2611-27420

Lot No. _____ Block _____ D.L. _____

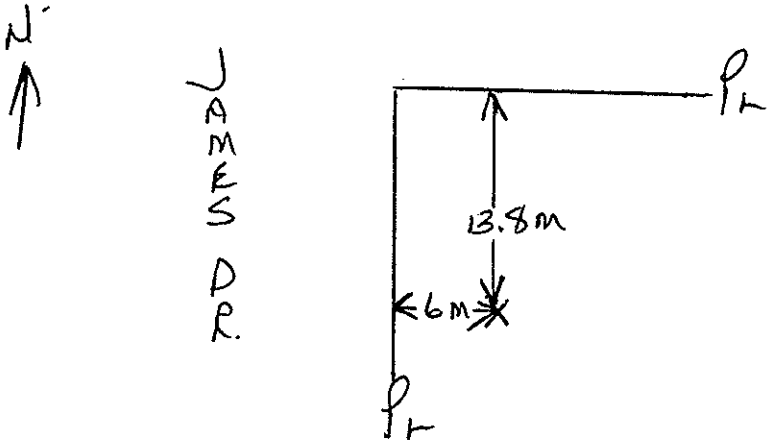Address 3770 JAMES CRT.Size of Connection 100mm 150mm 200mm Other _____Type of Connection Transite PVC Other _____Type of Cap Transite Cast Iron**LOCATION SKETCH**

JAMES CRT.

Field Location By L. Panko Date Jan 8/01

Checked by Foreman - Sewer Division _____