



City of Prince George  
**History Sheet**

PID:	006519598
SD/MU:	
WO:	

Civic Address: 3822 James Place

Legal Description: Lot: 24 District Lot: 2611 Plan: 27420


Service Type	Diameter (mm)	Material	Invert Elev at main (m)	Invert Elev at property line (m)	Invert Elev at service end (m)	Distance into property (m)	Installation Date
Sanitary	100mm	PVC	-	-	-	-	-
Water	20mm	Copper	-	-	-	-	
Storm	N/A	N/A	-	-	-	-	

Service Connection Location	Sanitary (m)	Storm (m)
100mm Sanitary service connected to San MH 3891	-	
Distance from downstream Stm MH - towards upstream Stm MH -		

Power	Size	Communications	Size	Cable	Size	Gas	Size
BC Hydro	-	Telus	-	Shaw	-	FortisBC	-
Underground Service		Underground Service		Underground Service			

Installed by:	Survey Date:	-
Comments:		

**NOT TO SCALE** The information contained herein is for internal use only.  
 Not to be relied on unless confirmed by site inspection and/or investigation.

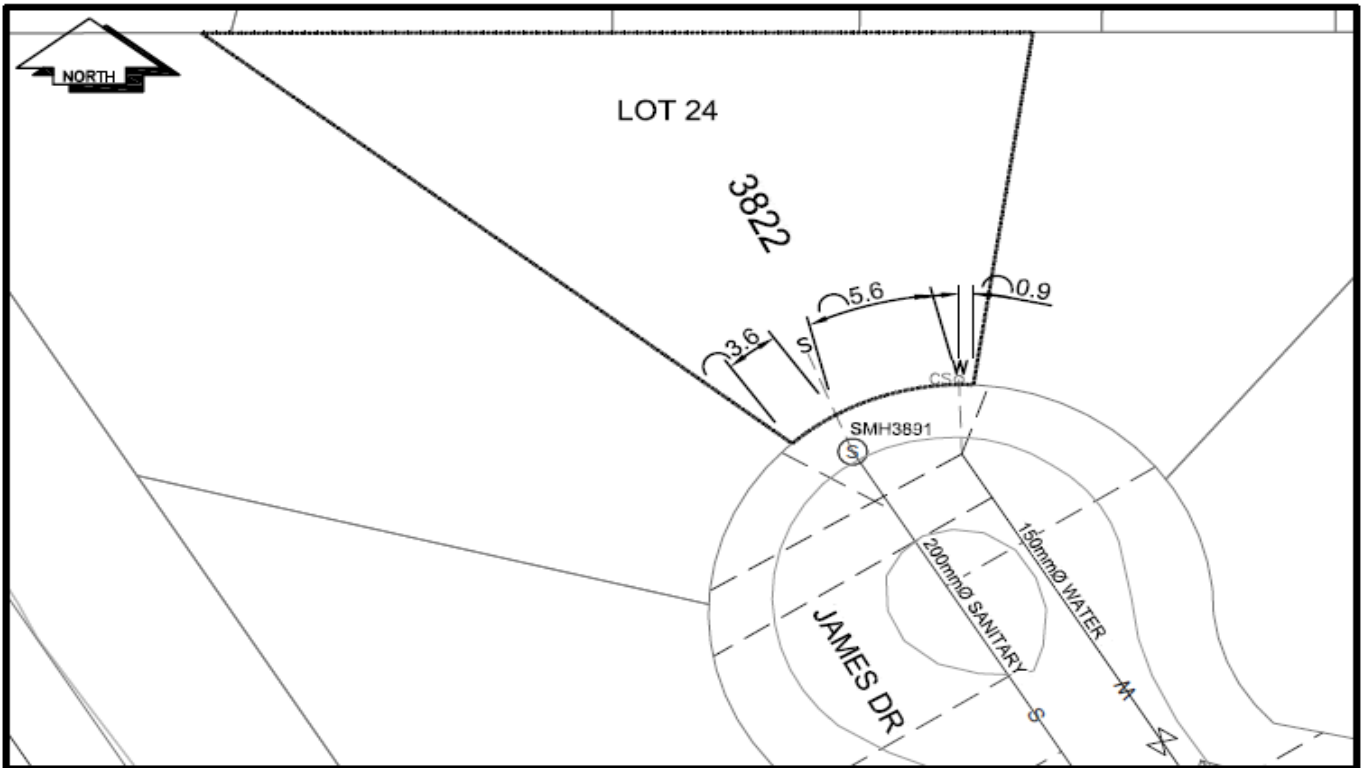

LEGEND:	
CS <sup>o</sup> CURB STOP	--- WATER SERVICE
CO <sup>o</sup> CLEAN OUT	--- SANITARY SERVICE
⊗ WATER VALVE	⊗ FIRE HYDRANT
	--- STORM SERVICE
	--- G GAS
	--- ENCUMBRANCE

**NOT TO SCALE**