



City of Prince George
History Sheet

PID:	006519806
SD/MU:	
WO:	

Civic Address: 3761 James Dr

Legal Description: Lot: 13 District Lot: 9265 Plan: 27420


Service Type	Diameter (mm)	Material	Invert Elev at main (m)	Invert Elev at property line (m)	Invert Elev at service end (m)	Distance into property (m)	Installation Date
Sanitary	100mm	PVC	-	599.39	2.27	-	December 1980
Water	20mm	Copper	-	-	-	-	December 1980
Storm	N/A	N/A	-	-	-	-	

Service Connection Location				Sanitary (m)	Storm (m)
Distance from downstream San MH	2060	towards upstream San MH	3896	81.37	
Distance from downstream Stm MH	-	towards upstream Stm MH	-		

Power	Size	Communications	Size	Cable	Size	Gas	Size
BC Hydro	-	Telus	-	Shaw	-	FortisBC	-
Underground Service		Underground Service		Underground Service			

Installed by:		Survey Date:	-
Comments:	Water location confirmed June 28, 2017		

NOT TO SCALE The information contained herein is for internal use only.
Not to be relied on unless confirmed by site inspection and/or investigation.

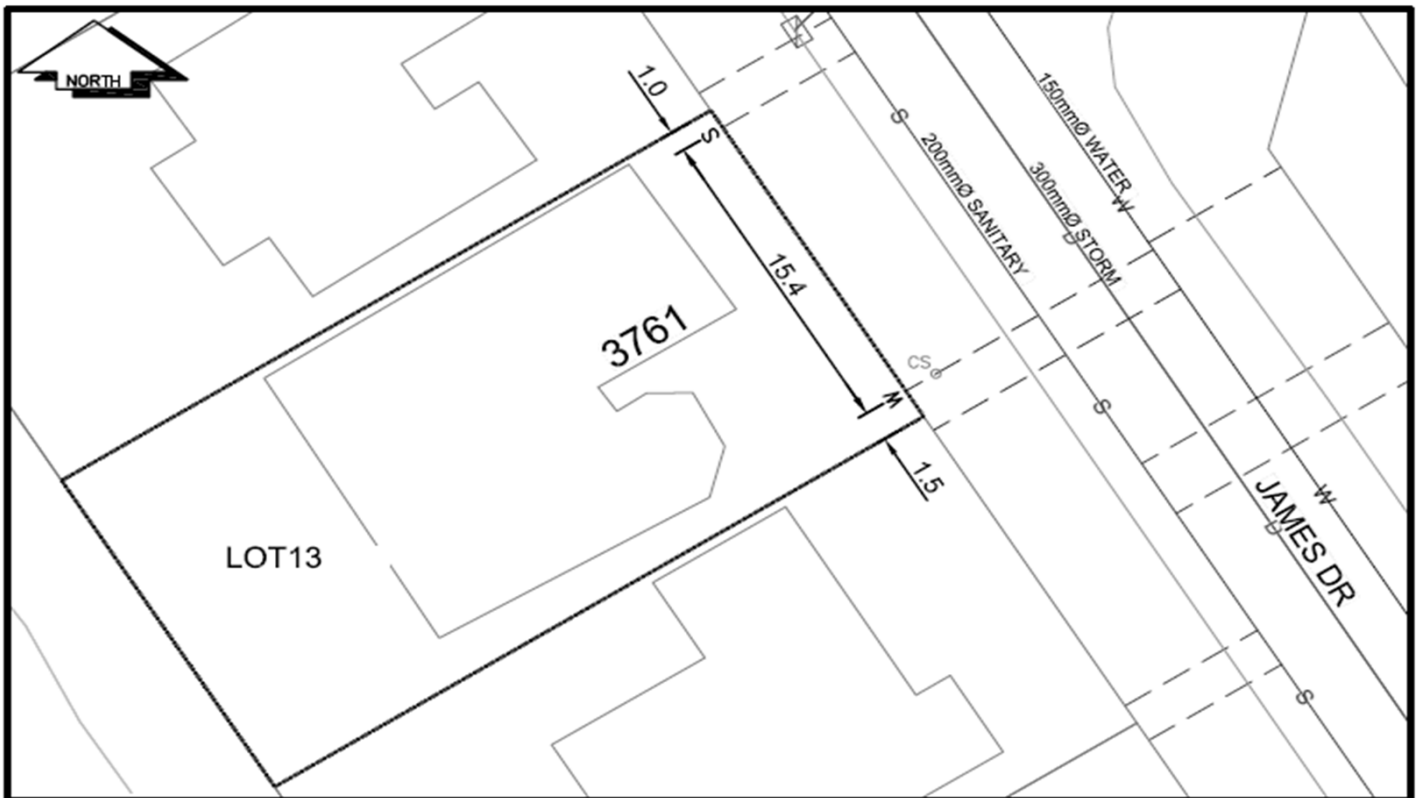

LEGEND:							
CS	CURB STOP	--- W ---	WATER SERVICE	--- S ---	SANITARY SERVICE	--- Ø ---	STORM SERVICE
CO	CLEAN OUT	---	GAS	---	ENCUMBRANCE		
⊗	WATER VALVE	⊗	FIRE HYDRANT				

NOT TO SCALE