

City of Prince George HISTORY SHEET

SHEET NUMBER

Roll Number 006522491

Legal: LOT'S 168 BLOCK _____ D.L. 1599 PLAN 15192

Address: 7713 THOMPSON DR.

Sanitary Connection: # 16081 SIZE 100mm MATERIAL _____ INV. _____ CONNECTED _____

Water Connection # _____ SIZE _____ MATERIAL _____ METER _____ CONNECTED _____

Storm Connection: # _____ SIZE _____ MATERIAL _____ INV. _____ CONNECTED _____

Cash Receipt No's: WATER _____ SANITARY 912. STORM _____

CURB FROM PROPERTY LINE _____ PAVEMENT WIDTH _____



B.C. HYDRO _____ UNDERGROUND CONNECTION _____

B.C. TELEPHONE _____ UNDERGROUND CONNECTION _____

INLAND GAS _____

Information Sheets: _____

Comments: _____

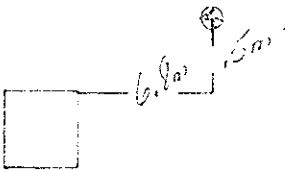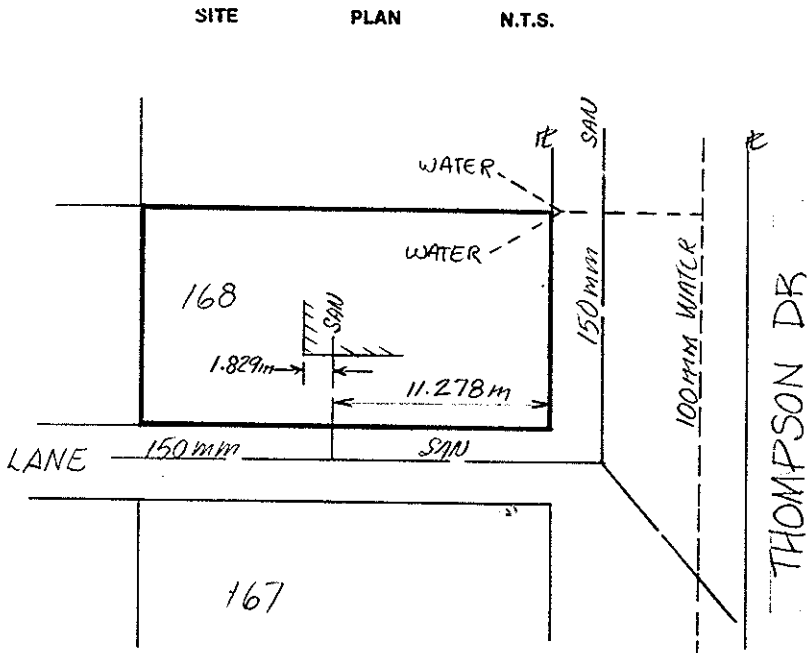

167