

# City of Prince George HISTORY SHEET

SHEET NUMBER **Nº 3843** Roll Number **006487370**

Legal: LOT'S **B** BLOCK D.L. **2013** PLAN **27415**

Address: **7875 ROCHESTER**

Sanitary Connection: # SIZE **4"** MATERIAL INV. CONNECTED

Water Connection # SIZE **3/4"** MATERIAL METER CONNECTED

Storm Connection: # SIZE MATERIAL INV. CONNECTED

Cash Receipt No's: WATER SANITARY STORM

CURB FROM PROPERTY LINE PAVEMENT WIDTH


B.C. HYDRO UNDERGROUND CONNECTION

B.C. TELEPHONE UNDERGROUND CONNECTION

INLAND GAS

Information Sheets:

Comments:

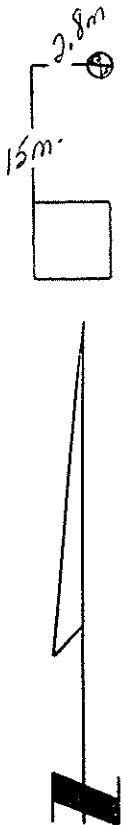

SITE

PLAN

N.T.S.

**ROCHESTER**

