



City of Prince George
History Sheet

| | |
|--------|-----------|
| PID: | 006591833 |
| SD/MU: | |
| WO: | |

Civic Address: 4821 Otway Rd

Legal Description: Lot: A District Lot: 2400 Plan: 27410


| Service Type | Diameter (mm) | Material | Invert Elev at main (m) | Invert Elev at property line (m) | Invert Elev at service end (m) | Distance into property (m) | Installation Date |
|--------------|---------------|----------|-------------------------|----------------------------------|--------------------------------|----------------------------|-------------------|
| Sanitary | N/A | N/A | - | - | - | - | - |
| Water | N/A | N/A | - | - | - | - | - |
| Storm | N/A | N/A | - | - | - | - | - |

| Service Connection Location | | | Sanitary (m) | Storm (m) |
|---------------------------------|---|-------------------------|--------------|-----------|
| Distance from downstream San MH | - | towards upstream San MH | - | |
| Distance from downstream Stm MH | - | towards upstream Stm MH | - | |

| Power | Size | Communications | Size | Cable | Size | Gas | Size |
|------------------|------|------------------|------|------------------|------|----------|------|
| BC Hydro | - | Telus | - | Shaw | - | FortisBC | - |
| Overhead Service | | Overhead Service | | Overhead Service | | | |

| | | |
|---------------|--------------|---|
| Installed by: | Survey Date: | - |
| Comments: | | |
| | | |
| | | |

NOT TO SCALE The information contained herein is for internal use only.
Not to be relied on unless confirmed by site inspection and/or investigation.

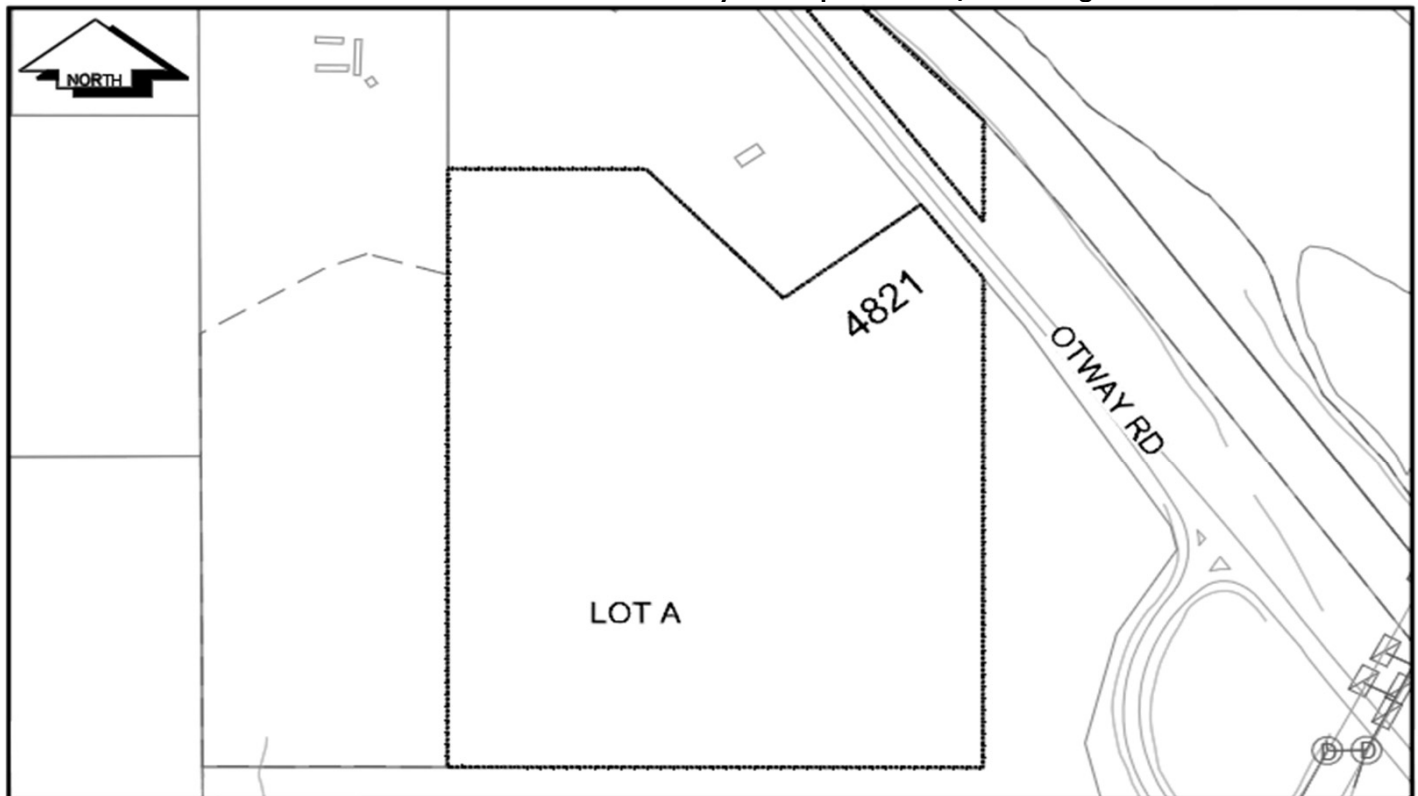

| LEGEND: | |
|-----------------|------------------|
| CS ^o | CURB STOP |
| CO ^o | CLEAN OUT |
| ⊗ | WATER VALVE |
| --- | WATER SERVICE |
| --- | SANITARY SERVICE |
| ⊕ | FIRE HYDRANT |
| --- | STORM SERVICE |
| —G— | GAS |
| --- | ENCUMBRANCE |

NOT TO SCALE