



City of Prince George
History Sheet

PID:	006619622
MU:	101393
WO:	72244/ 72245

Civic Address: 8377 Hart Hwy
Legal Description: Lot: 3 District Lot: 2424 Plan: 27174


Service Type	Diameter (mm)	Material	Invert Elev at main (m)	Invert Elev at property line (m)	Invert Elev at service end (m)	Distance into property (m)	Installation Date
Sanitary	150mm	PVC	-	-	-	-	July 2013
Water	40mm	Copper	-	-	-	-	July 2013
Storm	N/A	N/A	-	-	-	-	

Service Connection Location	Sanitary (m)	Storm (m)
Service connected to San MH 105	-	
Distance from downstream Stm MH - towards upstream Stm MH	-	

Power	Size	Communications	Size	Cable	Size	Gas	Size
BC Hydro	-	Telus	-	Shaw	-	FortisBC	-
Overhead Service		Overhead Service		Overhead Service			

Installed by:	City of Prince George forces	Survey Date:	-
Comments:			

NOT TO SCALE The information contained herein is for internal use only.
Not to be relied on unless confirmed by site inspection and/or investigation.

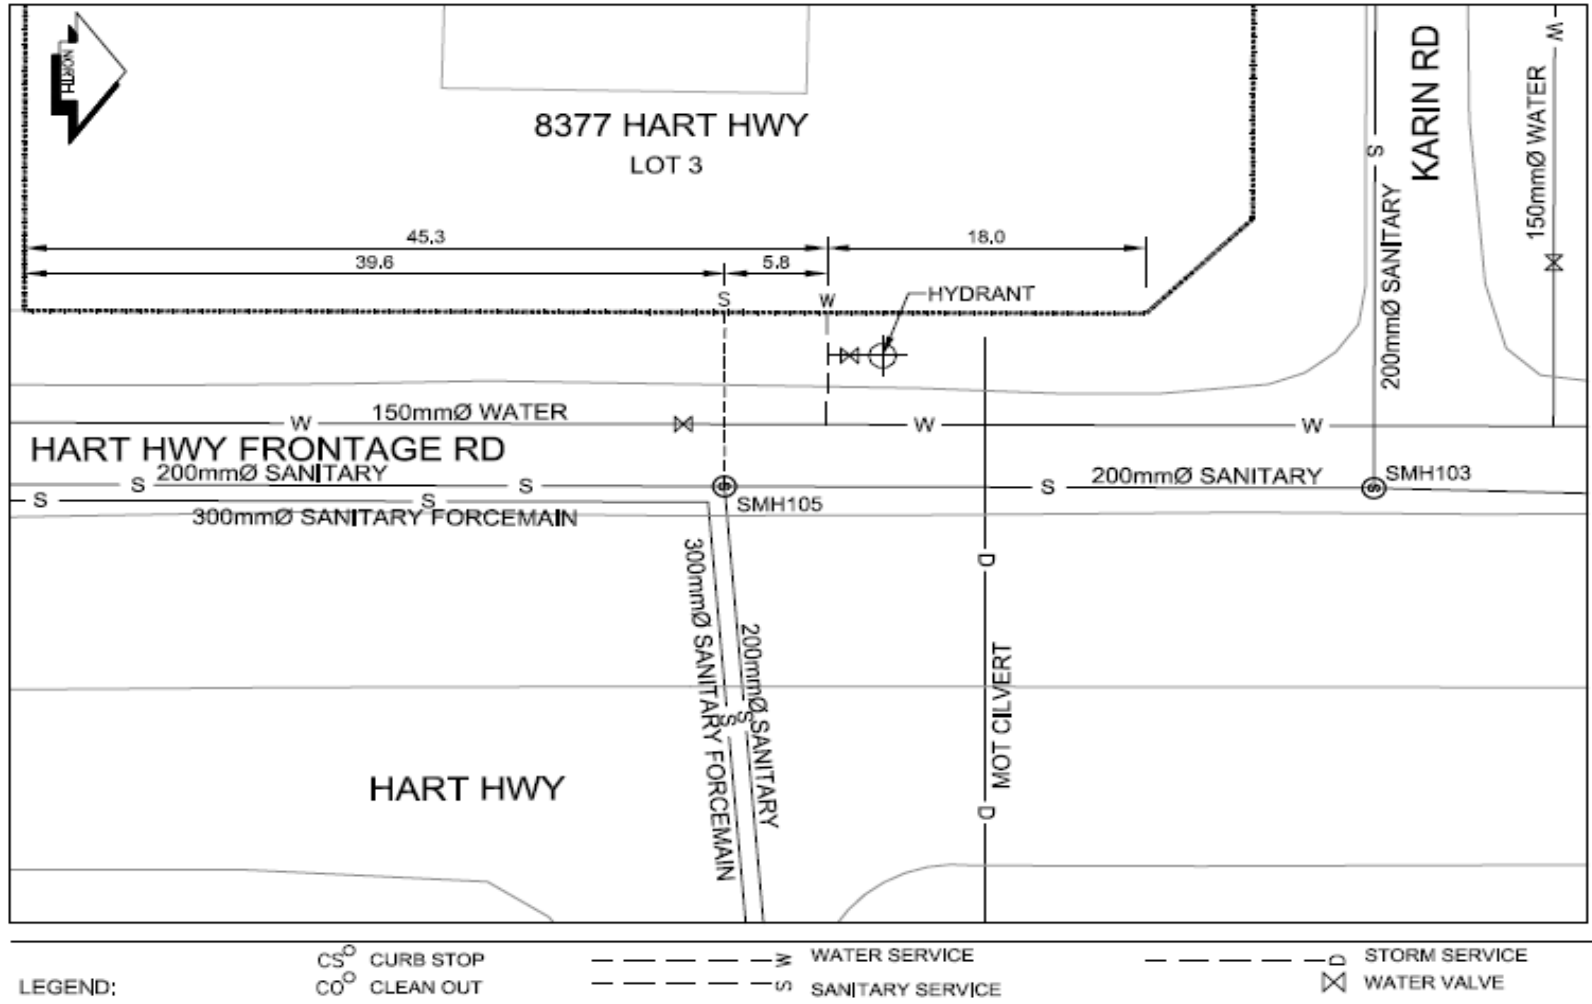

NOT TO SCALE