

City of Prince George HISTORY SHEET

SHEET NUMBER

Roll Number 006-686-150

Legal: LOT'S 67 BLOCK D.L. 8178 PLAN 20375

Address: 2870 SYCAMORE CRES.

Sanitary Connection: # 8309 SIZE 100mm. MATERIAL AC INV. CONNECTED

Water Connection # 8309 SIZE 20mm. MATERIAL CU METER CONNECTED

Storm Connection: # SIZE MATERIAL INV. CONNECTED

Cash Receipt No's: WATER SANITARY STORM

CURB FROM PROPERTY LINE 4.877m. PAVEMENT WIDTH 10.363m.

B.C. HYDRO U/G UNDERGROUND CONNECTION YES



B.C. TELEPHONE U/G UNDERGROUND CONNECTION YES.

INLAND GAS AS SHOWN.

Information Sheets:

Comments:

**THE INFORMATION CONTAINED HEREIN IS FOR INTERNAL USE ONLY.
NOT TO BE RELIED UPON UNLESS CONFIRMED BY SITE INSPECTION AND/OR INVESTIGATION**

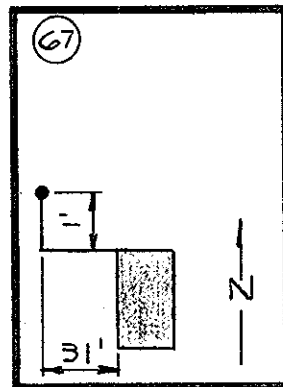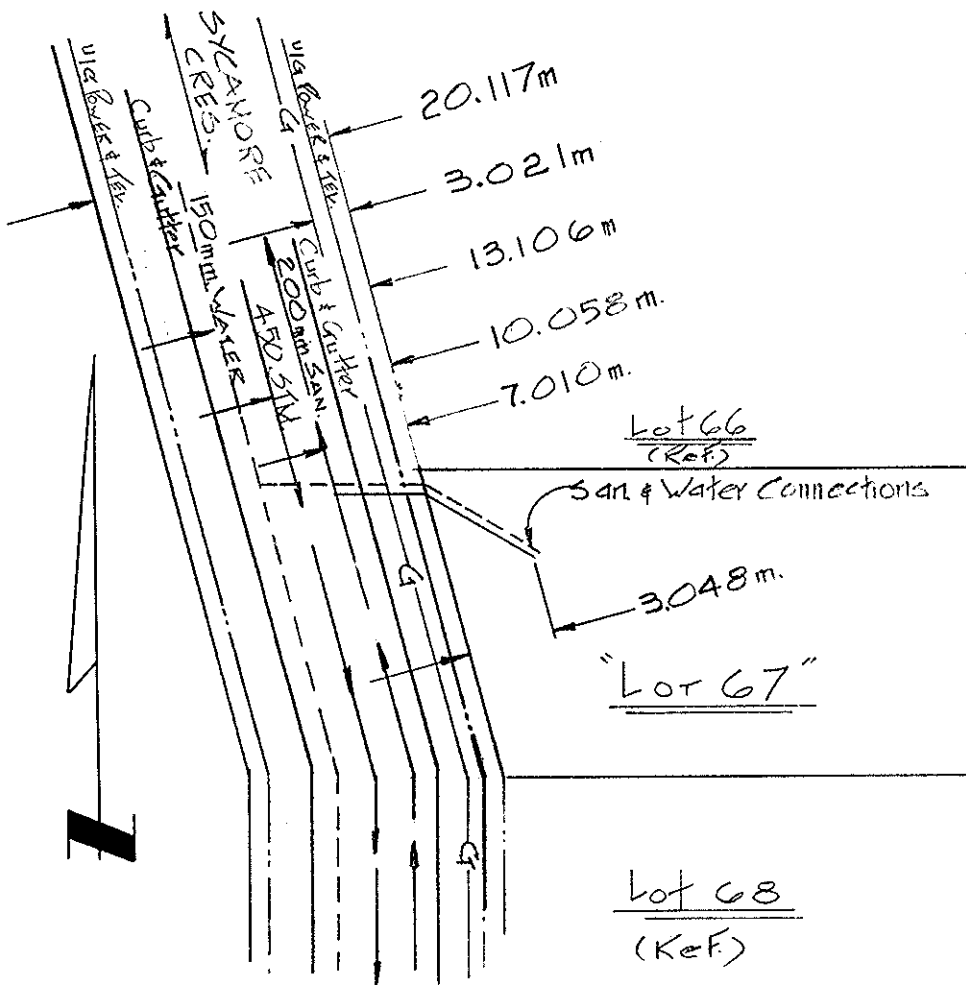

Lot 68
(KeF)