

City of Prince George HISTORY SHEET

SHEET NUMBER **Nº 0875** Roll Number **306694381**

Legal: LOT'S **A** BLOCK **4377** D.L. **4377** PLAN **26926**

Address: **1997 GAGNE PL.**

Sanitary Connection: # **12976** SIZE **4"** MATERIAL **INV.** **CONNECTED**

Water Connection # **12976** SIZE **3/4"** MATERIAL **METER** **CONNECTED**

Storm Connection: # **3476** SIZE **3477** MATERIAL **INV.** **CONNECTED**

Cash Receipt No's: WATER **3476** SANITARY **3477** STORM

CURB FROM PROPERTY LINE PAVEMENT WIDTH

B.C. HYDRO UNDERGROUND CONNECTION


B.C. TELEPHONE UNDERGROUND CONNECTION

INLAND GAS

Information Sheets:

Comments:

**THE INFORMATION CONTAINED HEREIN IS FOR INTERNAL
USE ONLY. NOT TO BE RELIED UPON UNLESS CONFIRMED
BY SITE INSPECTION AND/OR INVESTIGATION.**

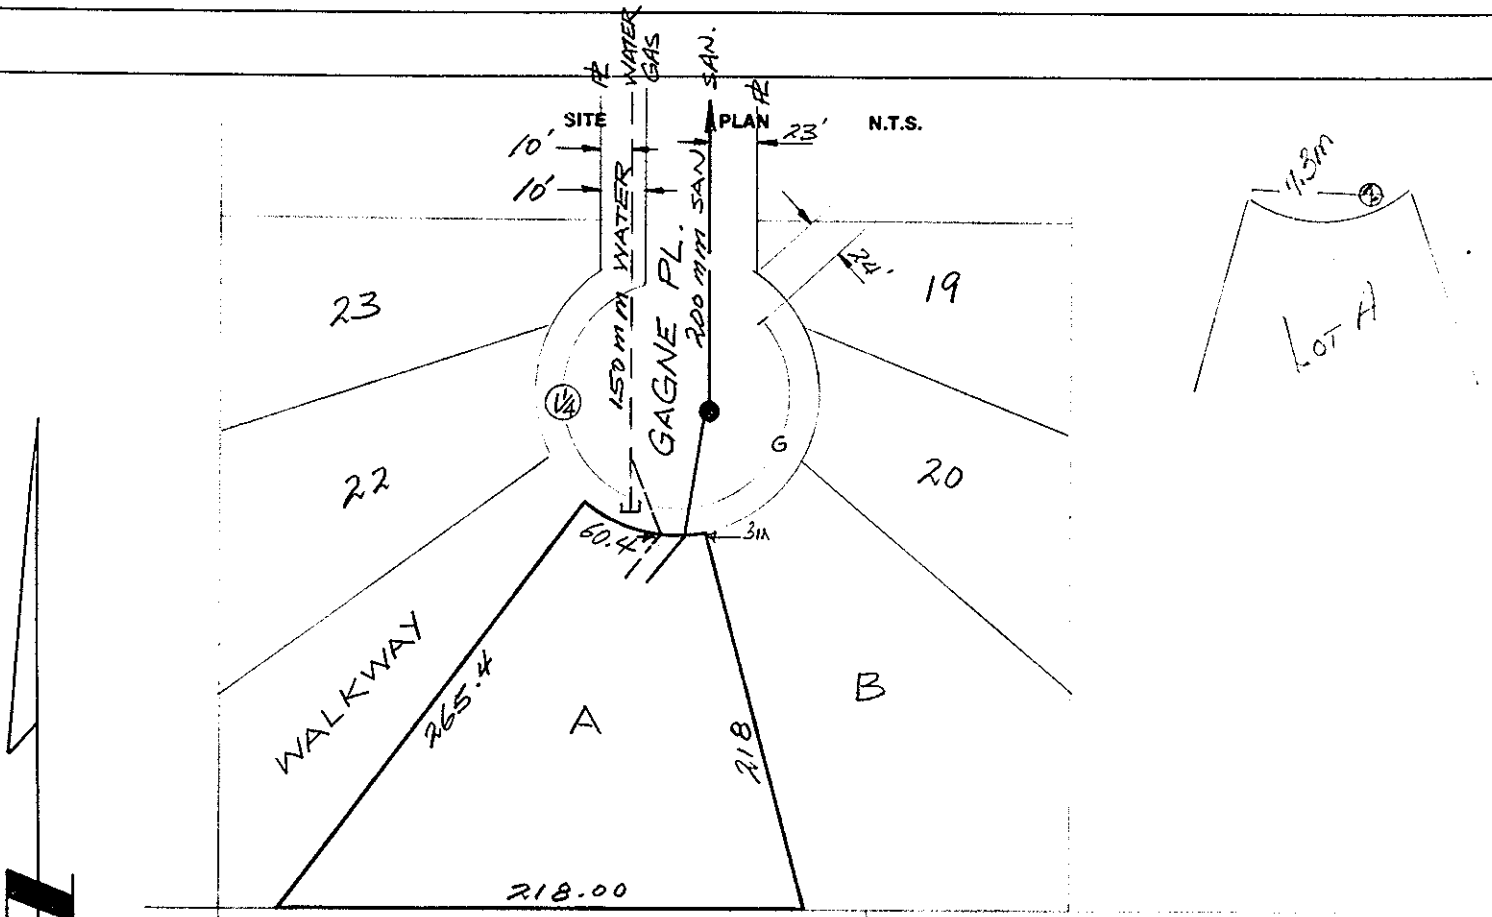

PLAN 1329

PLAN 15401