



City of Prince George
History Sheet

PID:	006701035
	006701043
	006701060
SD/MU:	
WO:	

Civic Address: 2872, 2888 PiperRd

Legal Description: Lot: 4, 5, 6 Block: 29 District Lot: 629 Plan: 902

Service Type	Diameter (mm)	Material	Invert Elev at main (m)	Invert Elev at property line (m)	Invert Elev at service end (m)	Distance into property (m)	Installation Date
Sanitary (S1)	100mm	AC	-	-	-	-	December 1976
Sanitary (S2)	200mm	PVC	-	-	-	-	December 1976
Water	20mm	Copper	688.35	688.40	-	-	January 2016
Storm	N/A	N/A	-	-	-	-	


Service Connection Location				Sanitary (m)	Storm (m)
Distance from downstream San MH	3330	towards upstream San MH	3331	39.64	
Distance from downstream San MH	3330	towards upstream San MH	33321	30.92	

Power	Size	Communications	Size	Cable	Size	Gas	Size
BC Hydro	-	Telus	-	Shaw	-	FortisBC	-
Overhead Service		Overhead Service		Overhead Service			

Installed by: City of Prince George forces Survey Date: -

Comments:

NOT TO SCALE The information contained herein is for internal use only.
Not to be relied on unless confirmed by site inspection and/or investigation.

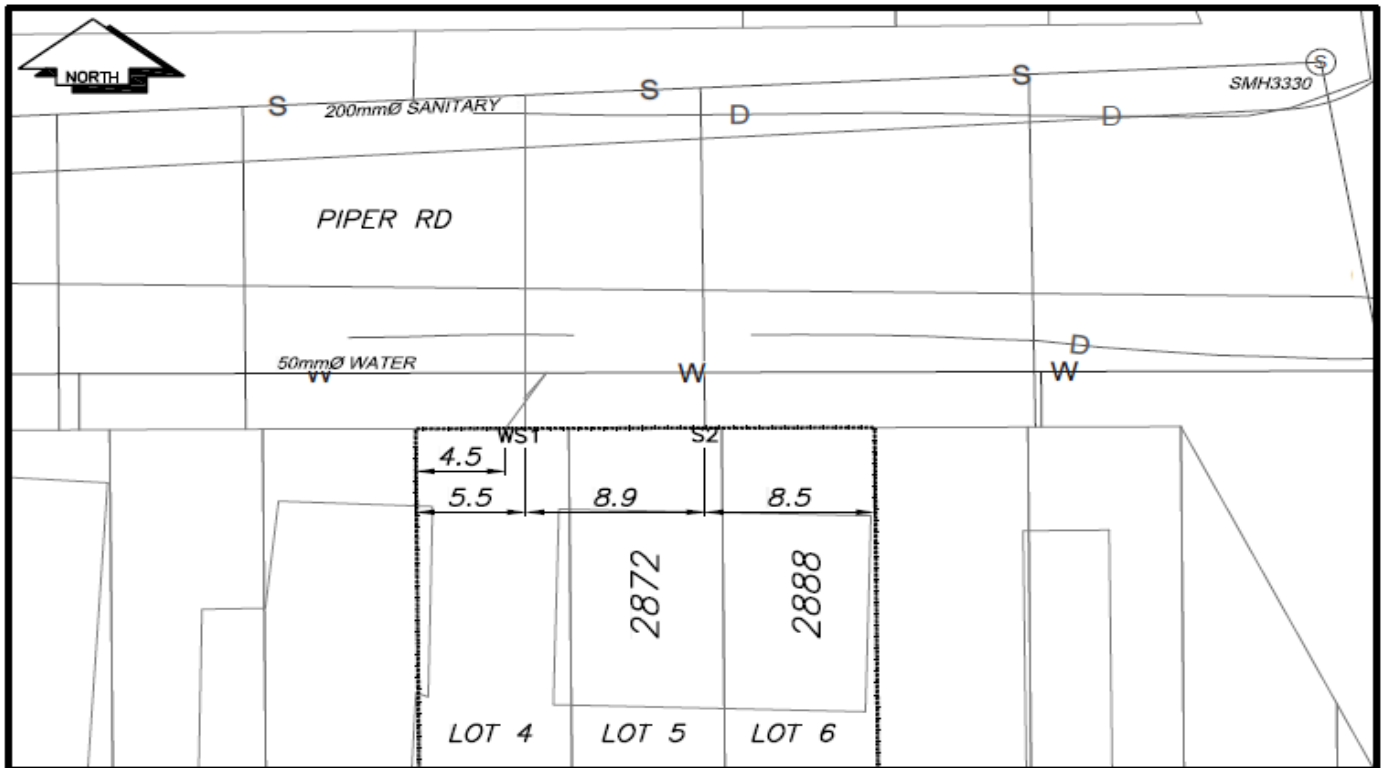

LEGEND:

CS ^o CURB STOP	—W— WATER SERVICE	—D— STORM SERVICE
CO ^o CLEAN OUT	- - - - S SANITARY SERVICE	—G— GAS
⊗ WATER VALVE	—F— FIRE HYDRANT	- - - - ENCUMBERANCE

NOT TO SCALE