



City of Prince George
History Sheet

PID:	006723616
SD/MU:	
WO:	

Civic Address: 4952 Banzer Dr

Legal Description: Lot: 33 District Lot: 4039 Plan: 27213


Service Type	Diameter (mm)	Material	Invert Elev at main (m)	Invert Elev at property line (m)	Invert Elev at service end (m)	Distance into property (m)	Installation Date
Sanitary	100mm	PVC	-	-	-	-	January 1980
Water	20mm	Copper	-	-	-	-	January 1980
Storm	100mm	PVC	-	-	-	-	January 1980

Service Connection Location				Sanitary (m)	Storm (m)
Distance from downstream San MH	1267	towards upstream San MH	1264	76.97	
Distance from downstream Stm MH	2046	towards upstream Stm MH	1281		77.84

Power	Size	Communications	Size	Cable	Size	Gas	Size
BC Hydro	-	Telus	-	Shaw	-	FortisBC	-
Overhead Service		Overhead Service		Overhead Service			

Installed by:	Survey Date:	-
Comments: Sanitary and storm services location confirmed October 2004		

NOT TO SCALE The information contained herein is for internal use only.
 Not to be relied on unless confirmed by site inspection and/or investigation.

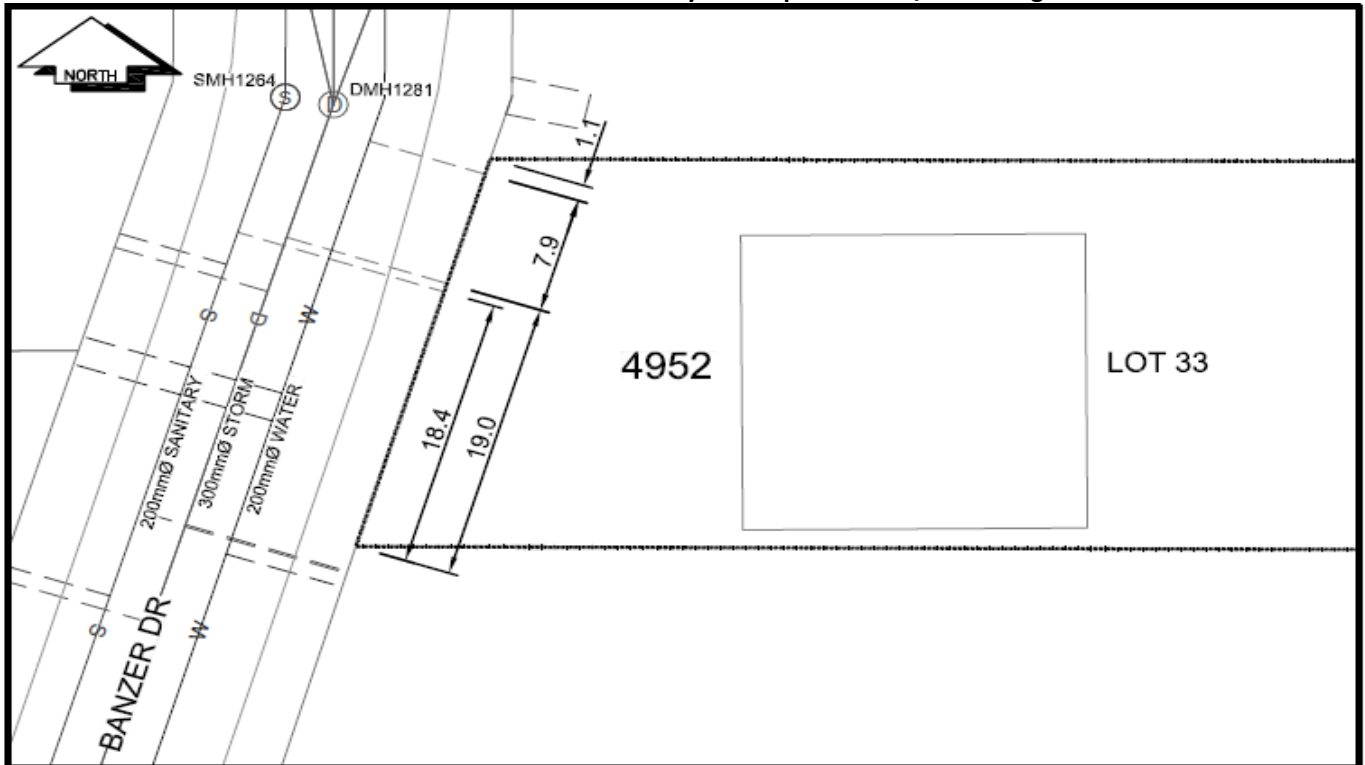

LEGEND:	
CS	CURB STOP
CO	CLEAN OUT
⊗	WATER VALVE
---	WATER SERVICE
---	SANITARY SERVICE
⊗	FIRE HYDRANT
---	STORM SERVICE
---	GAS
---	ENCUMBRANCE

NOT TO SCALE