



City of Prince George
History Sheet

PID:	006750338
	006750354
	006750419
	006750443
	006010237
	006010245
SD/MU:	
WO:	

Civic Address: 375, 385, 395 Victoria St
 1550 4th Ave

Legal Description: Lot: 13 -18 Block: 130 District Lot: 343 Plan: 1268


Service Type	Diameter (mm)	Material	Invert Elev at main (m)	Invert Elev at property line (m)	Invert Elev at service end (m)	Distance into property (m)	Installation Date
Sanitary (S1)	100mm	AC	-	-	-	-	January 1959
Sanitary (S2)	100mm	AC	-	-	-	-	January 1959
Sanitary (S3)	100mm	AC	-	-	-	-	January 1959
Sanitary (S4)	100mm	AC	-	-	-	-	January 1959
Water	20mm	Copper	-	-	-	-	January 1957
Storm	200mm	C.I.P.	-	-	-	-	January 1973

Service Connection Location			Sanitary (m)	Storm (m)
Distance from downstream San MH	-	towards upstream San MH	-	
200mm Storm main connected to Stm 2244				

Power	Size	Communications	Size	Cable	Size	Gas	Size
BC Hydro	-	Telus	-	Shaw	-	FortisBC	-
Overhead Service		Overhead Service		Overhead Service			

Installed by:	Survey Date:	-
Comments:		

NOT TO SCALE The information contained herein is for internal use only.
 Not to be relied on unless confirmed by site inspection and/or investigation.

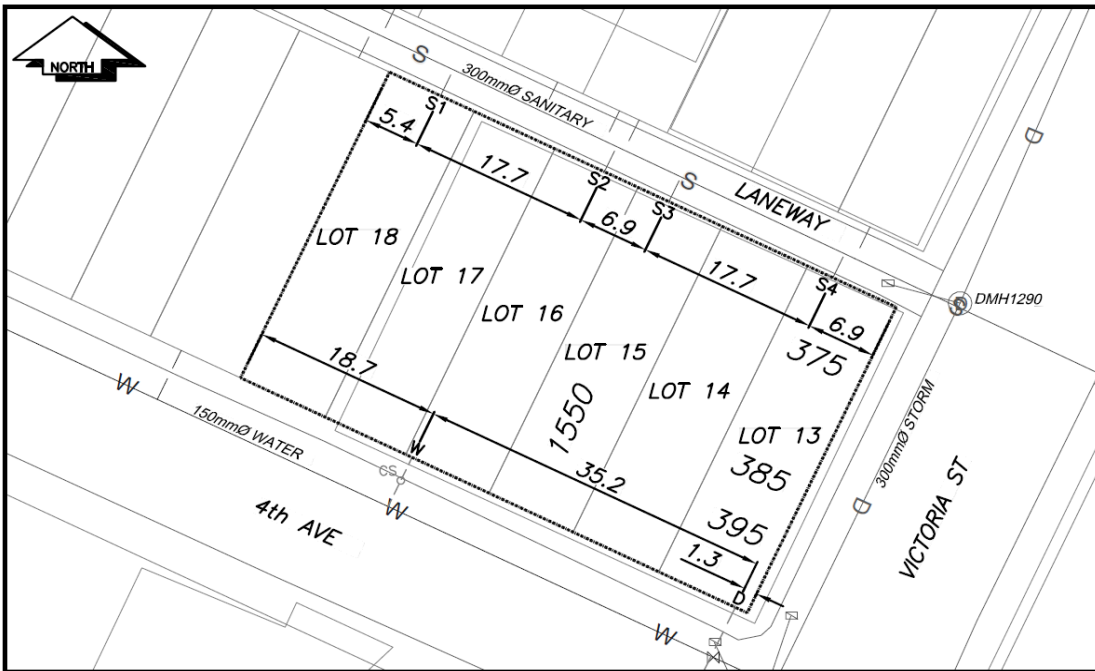

LEGEND:			
CS	CURB STOP	—	WATER SERVICE
CO	CLEAN OUT	—S	SANITARY SERVICE
⊗	WATER VALVE	⊗	FIRE HYDRANT
		—G—	GAS
		---	ENCUMBRANCE

NOT TO SCALE