

City of Prince George
HISTORY SHEET

SHEET NUMBER

PID # 006753353

Legal: LOT'S 13 BLOCK D.L. 4047 PLAN 27039

Address: 6501 DRIFTWOOD RD

Sanitary Connection: # SIZE 100 mm MATERIAL INV. CONNECTED

Water Connection: # SIZE 20 mm MATERIAL METER CONNECTED

Storm Connection: # SIZE 100 mm MATERIAL INV. CONNECTED

Cash Receipt No's: WATER SANITARY STORM

CURB FROM PROPERTY LINE PAVEMENT WIDTH

B.C. HYDRO UNDERGROUND CONNECTION


B.C. TELEPHONE UNDERGROUND CONNECTION

INLAND GAS

Information Sheets:

Comments:

THE INFORMATION CONTAINED HEREIN IS FOR INTERNAL USE ONLY.
NOT TO BE RELIED UPON UNLESS CONFIRMED BY SITE INSPECTION AND/OR INVESTIGATION

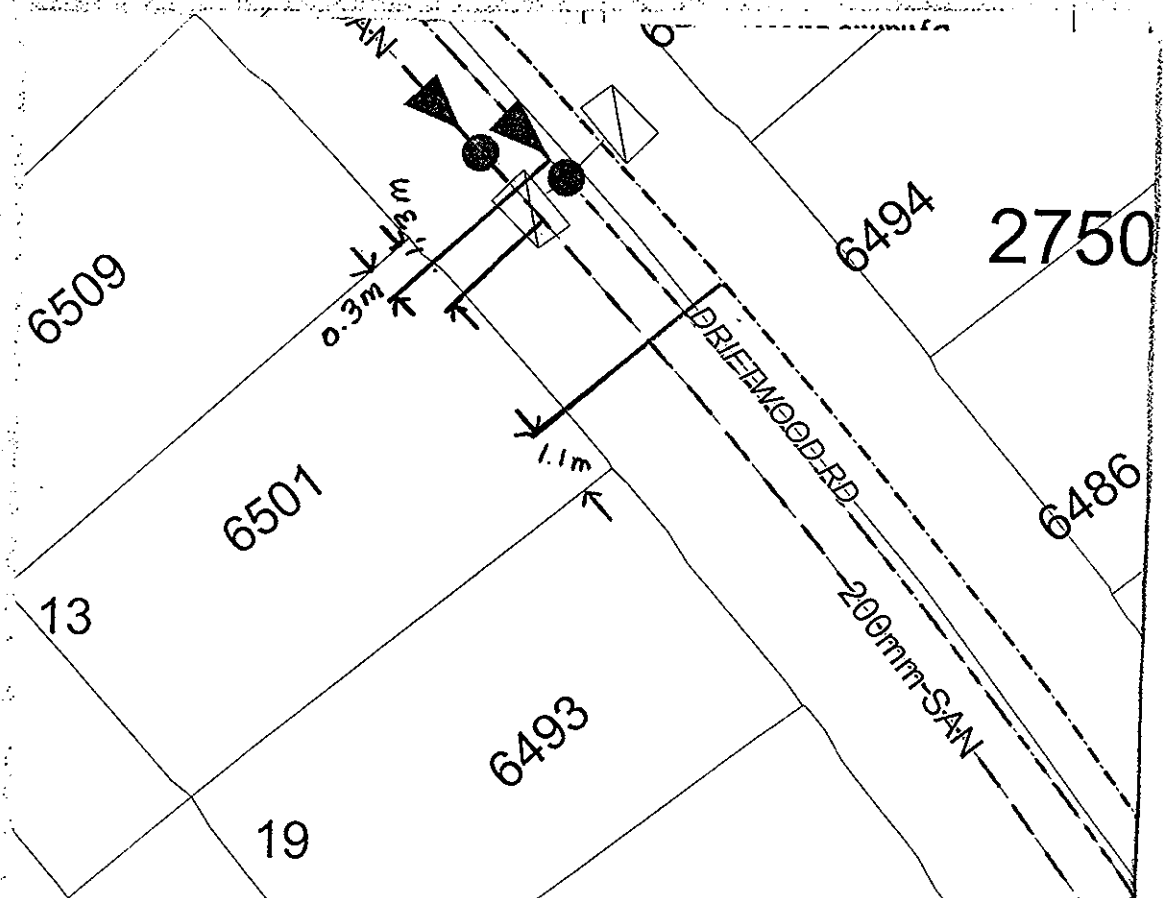

REPORT TO RECORDS

WATER SERVICE INFORMATION

FAXED
OCT. 8/02
3:33 PM
H

Lot No. _____ Block _____ D.L. _____


Address 6501 PREFTWOOD

Size of Connection 1/2" 3/4" Other _____

Type of Connection Copper Iron

Thaw Wire Yes No

LOCATION SKETCH

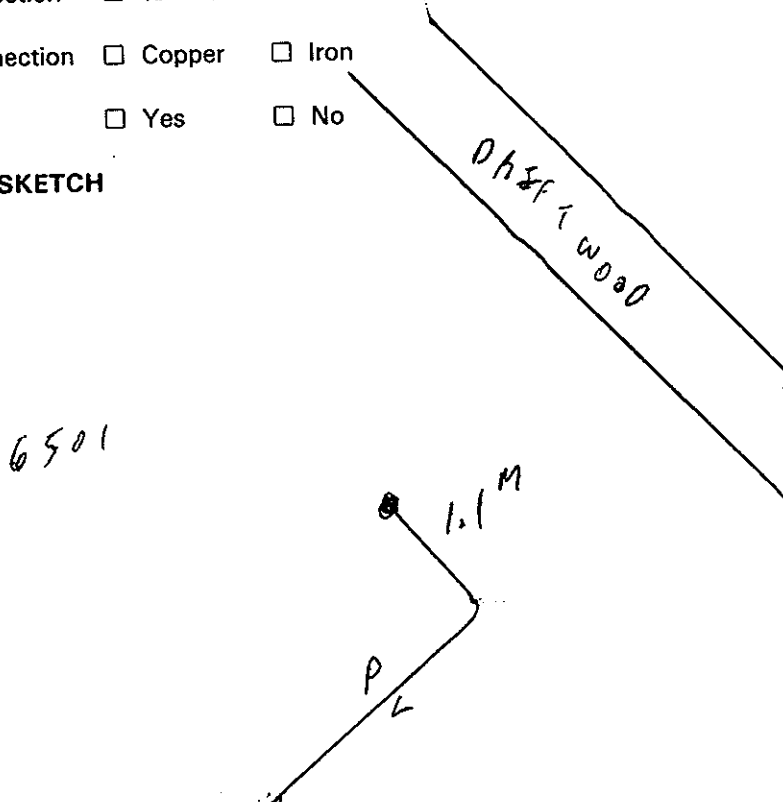

Field Location By Alan A. Cross Date Oct. 8/02

Checked by: _____

REPORT TO RECORDS

SEWER SERVICE INFORMATION

FAXED
Oct 8/02
3:33 PM
H

Lot No. _____ Block _____ D.L. _____


Address 6501 DRIFTWOOD

Size of Connection 100mm 150mm 200mm Other _____

Type of Connection Transite PVC Other _____

Type of Cap Transite Cast Iron

LOCATION SKETCH

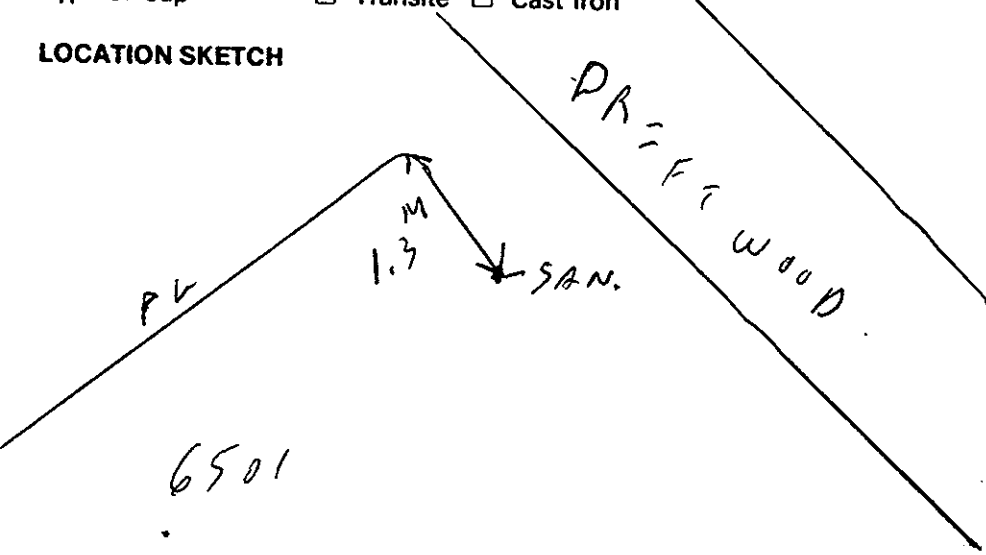

Field Location By Alain Le Goff Date Oct. 8/02

Checked by Foreman - Sewer Division _____

REPORT TO RECORDS

STORM SEWER SERVICE INFORMATION

FAXED
Oct 8/02
3:33 PM
H

Lot No. _____ Block _____ D.L. _____


Address 6501 DRIFTWOOD

Size of Connection 100mm 150mm 200mm Other _____

Type of Connection Transite PVC Other _____

Type of Cap Transite Cast Iron

LOCATION SKETCH

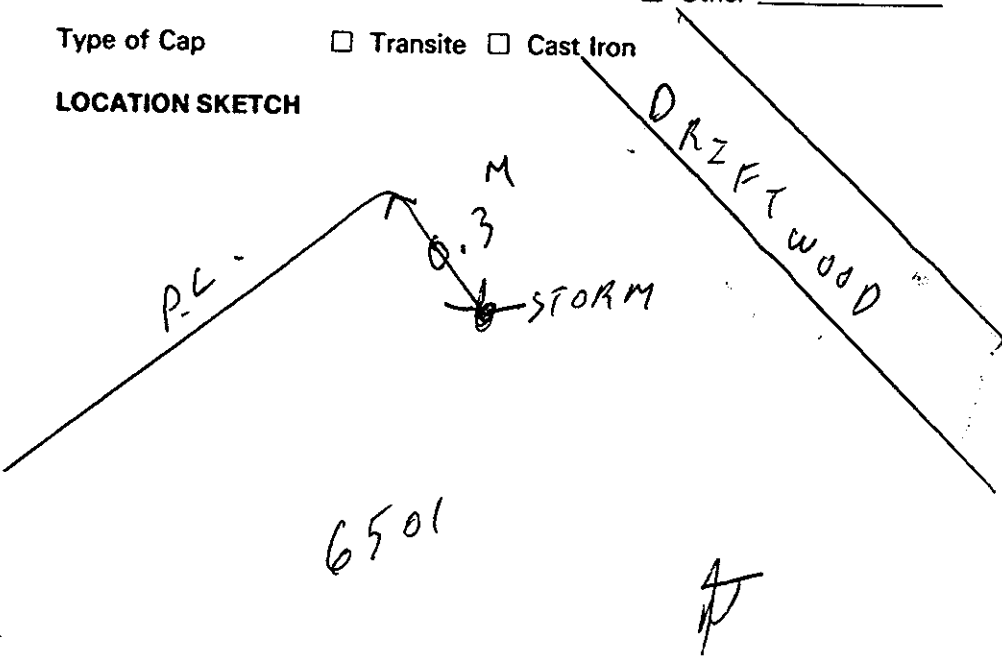

Field Location By Alain H. Green Date Oct. 6/02

Checked by Foreman - Sewer Division _____