
City of Prince George HISTORY SHEET

Sanitary Connection: # B.C. HYDRO Legal: Comments: Information Sheets: INLAND GAS B.C. TELEPHONE CURB FROM PROPERTY LINE Cash Receipt No's: Water Connection SHEET NUMBER Storm Connection: LOT'S Z * #≄ 20 1935 1) 1/ HORMB BLOCK 3218 SIZE SIZE SANITARY MATERIAL UNDERGROUND CONNECTION MATERIAL UNDERGROUND CONNECTION MATERIAL 2 N. METER Z PAVEMENT WIDTH Roll Number STORM PLAN 00677368 2685 CONNECTED CONNECTED CONNECTED

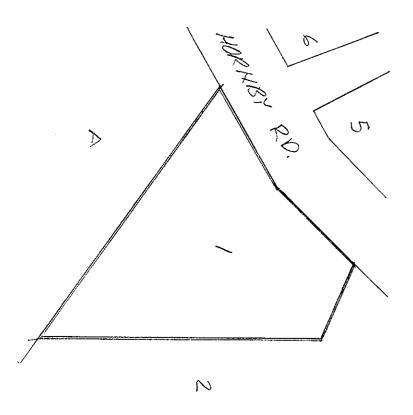

PL N

N.T.S.