

# City of Prince George

## HISTORY SHEET

PID: **006859534**

Scale: 1:1000

Legal: 16

D.L.: 2424

PLAN: 10807

Address: **4952 CHIEF LAKE ROAD**

Sanitary Connection: 16650      SIZE: 100mmØ      MATERIAL: PVC      INV. 758.45m      CONNECTED

Water Connection:      SIZE: 19mmØ      MATERIAL: COPPER      INV. 759.21m      CONNECTED

Storm Connection:      SIZE      MATERIAL      INV.

Cash Receipt No's:      WATER      SANITARY      STORM

CURB FROM PROPERTY LINE      PAVEMENT WIDTH

HYDRO      -      O/H CONNECTION


TELEPHONE      -      O/H CONNECTION

GAS      -

Information Sheets:      -

Comments:      CS<sup>o</sup> CURB STOP      W WATER SERVICE      GAS GAS  
                  CO<sup>o</sup> CLEAN OUT      S SANITARY SERVICE      E ELECTRICAL

**THE INFORMATION CONTAINED HEREIN IS FOR INTERNAL USE ONLY.  
 NOT TO BE RELIED UPON UNLESS CONFIRMED BY THE SITE INSPECTION AND/OR INVESTIGATION**

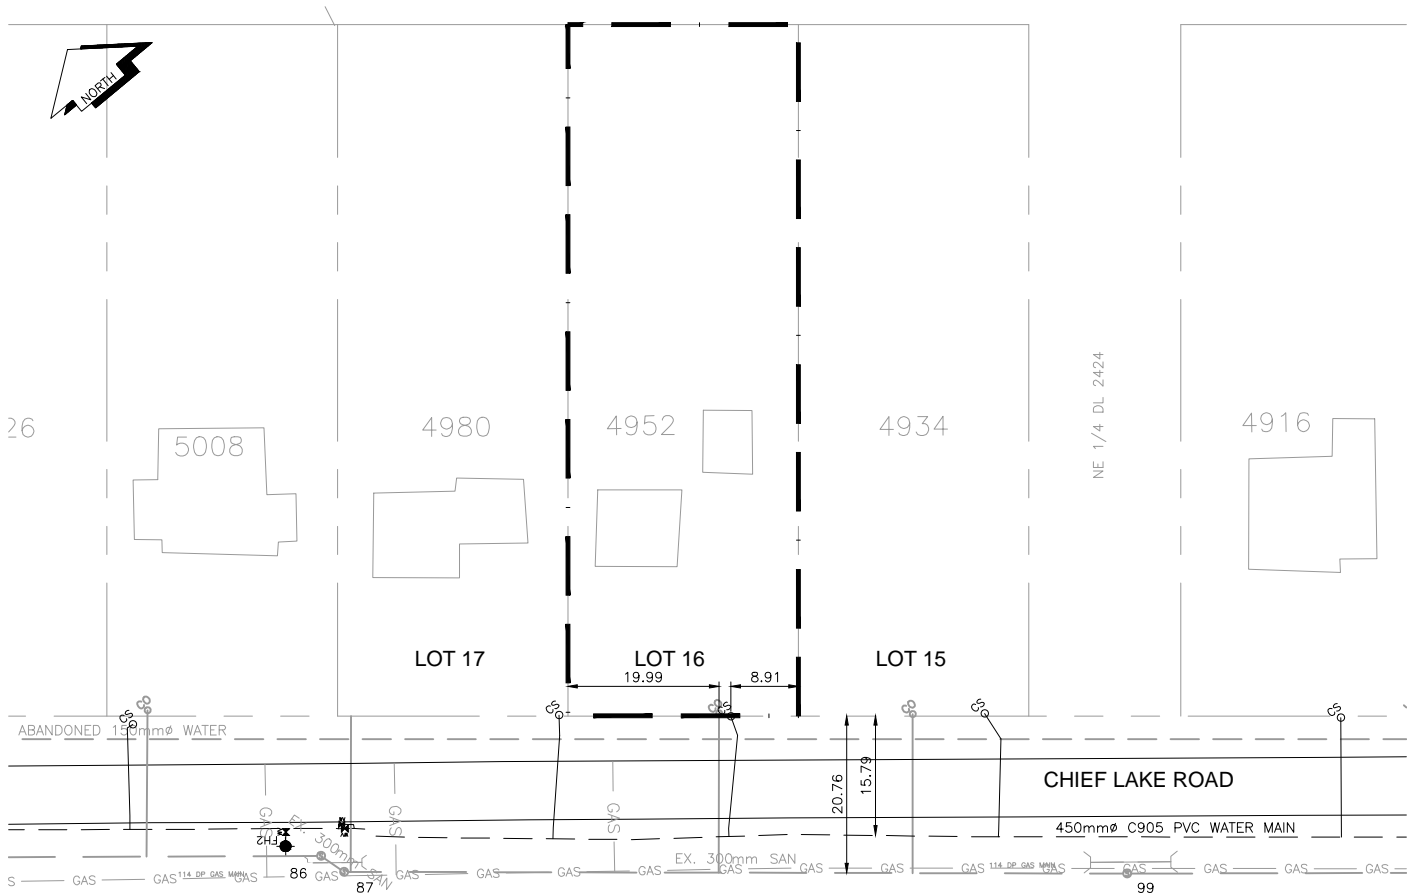

SANITARY, STORM & WATER SERVICE INVERTS	SANITARY	WATER	STORM
1. Distance from San. M.H. <u>99</u> toward San. M.H. <u>87</u> to lot service connection point is:	54.03m	52.68m	
2. Main Size at connection point is	100mmØ	19mmØ	
3. Obvert of main at conn. stub point is	756.97m	758.96m	
4. Obvert at service end is		759.23m	
5. Cover at property line in meters			
6. Survey Date: NOV 2014 Book Ref.:1035-55 By:L&M			

**SANITARY HISTORY:**

DATE INSTALLED: -

INSTALLED BY: -

**WATER HISTORY:**

DATE INSTALLED: SEPT 2014

INSTALLED BY: CoPG

**STORM HISTORY:**

DATE INSTALLED: -

INSTALLED BY: -