

**City of Prince George  
HISTORY SHEET**

0-000-14

FM

SHEET NUMBER \_\_\_\_\_ Roll Number \_\_\_\_\_

Legal: LOT'S 263 BLOCK — D.L. 482 PLAN 20916

Address: 4529 VALLEY CRES.

Sanitary Connection: # 8749 SIZE 100mm MATERIAL A.C. INV. \_\_\_\_\_ CONNECTED \_\_\_\_\_

Water Connection # 8749 SIZE 20mm MATERIAL COPPER METER \_\_\_\_\_ CONNECTED \_\_\_\_\_

Storm Connection: # \_\_\_\_\_ SIZE \_\_\_\_\_ MATERIAL \_\_\_\_\_ INV. \_\_\_\_\_ CONNECTED \_\_\_\_\_

Cash Receipt No's: WATER \_\_\_\_\_ SANITARY \_\_\_\_\_ STORM \_\_\_\_\_

CURB FROM PROPERTY LINE 4.877m PAVEMENT WIDTH 10.363m

B.C. HYDRO U/G UNDERGROUND CONNECTION \_\_\_\_\_



B.C. TELEPHONE U/G UNDERGROUND CONNECTION \_\_\_\_\_

INLAND GAS AS SHOWN

Information Sheets: \_\_\_\_\_

Comments: WITH THAW WIRE.

**THE INFORMATION CONTAINED HEREIN IS FOR INTERNAL USE ONLY.  
NOT TO BE RELIED UPON UNLESS CONFIRMED BY SITE INSPECTION AND/OR INVESTIGATION**

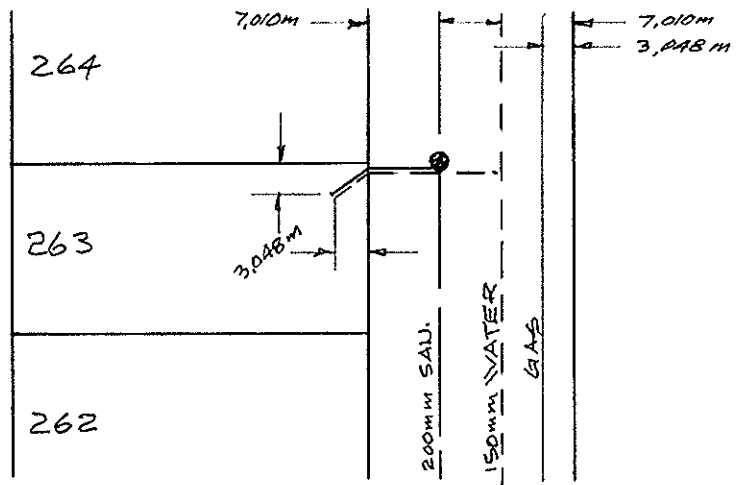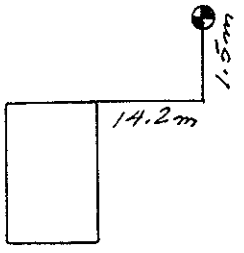

VALLEY  
CRES.