

**City of Prince George
HISTORY SHEET**

006-903-118

SHEET NUMBER

Roll Number

Legal: LOT'S 76 BLOCK D.L. 2610. PLAN 16.510.

Address: 537 PORTAGE.

Sanitary Connection: # 5503 SIZE 100mm MATERIAL A.C. INV. 603.941 CONNECTED

Water Connection # 5503 SIZE 20mm MATERIAL Cu. METER CONNECTED

Storm Connection: # _____ SIZE _____ MATERIAL _____ INV. _____ CONNECTED

Cash Receipt No's: WATER _____ SANITARY _____ STORM _____

CURB FROM PROPERTY LINE 4.877 m PAVEMENT WIDTH 10.363 m


B.C. HYDRO U/G UNDERGROUND CONNECTION

B.C. TELEPHONE U/G UNDERGROUND CONNECTION


INLAND GAS 3.048m FROM FL

Information Sheets:

Comments:

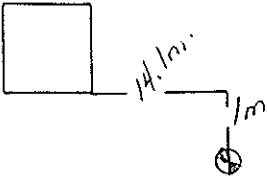

SITE PLAN N.T.S.

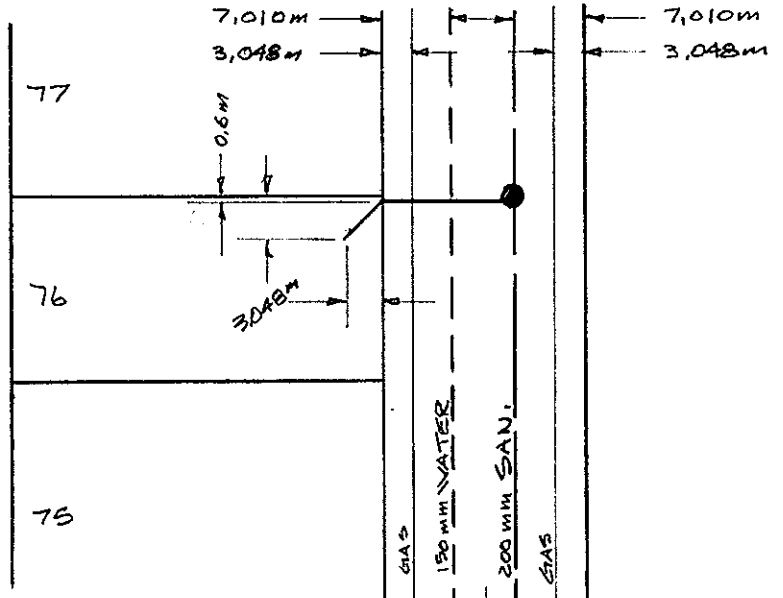

PORTAGE
ST.