

**City of Prince George
HISTORY SHEET**

006915094

SHEET NUMBER

Roll Number

108

Legal: LOT'S 15-16 BLOCK 99 D.L. 937 PLAN 752

Address: 126 N. KELLY ST

Sanitary Connection: # 3208 SIZE 100mm MATERIAL A.C. INV. 596.736 CONNECTED ✓

Water Connection # 3258 SIZE 20mm MATERIAL CU. METER CONNECTED ✓

Storm Connection: # SIZE MATERIAL INV. CONNECTED

Cash Receipt No's: WATER SANITARY STORM

CURB FROM PROPERTY LINE 4.877 m PAVEMENT WIDTH 10.363 m


B.C. HYDRO O/H UNDERGROUND CONNECTION

B.C. TELEPHONE O/H UNDERGROUND CONNECTION


INLAND GAS 1.524 m FROM R IN LANE.

Information Sheets:

Comments: WITH THAW WIRE.

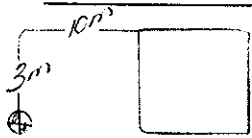

SITE PLAN N.T.S.

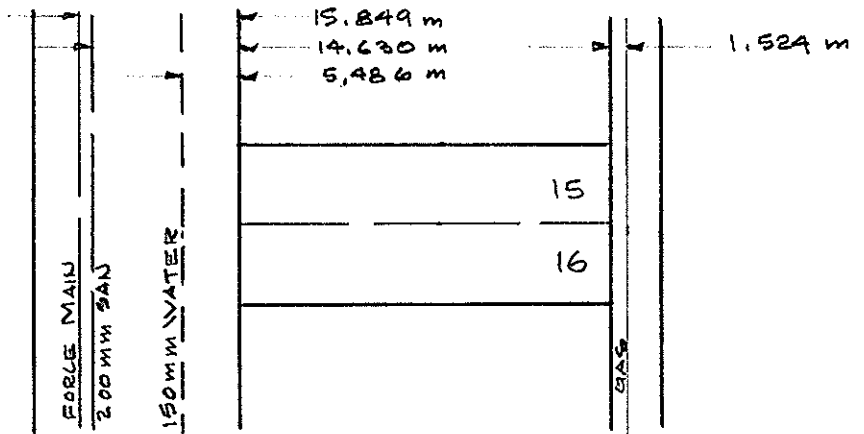

N. KELLY ST.

