

**City of Prince George
HISTORY SHEET**

47-
47
468

SHEET NUMBER

Roll Number

Legal: LOT'S 41-45 BLOCK 63 D.L. 629 PLAN 902

Address: 2623-2659 GUNN ROAD

Sanitary Connection: # 11243 SIZE 4" MATERIAL AC. INV. _____ CONNECTED

Water Connection # _____ SIZE _____ MATERIAL _____ METER _____ CONNECTED

Storm Connection: # _____ SIZE _____ MATERIAL _____ INV. _____ CONNECTED

Cash Receipt No's: WATER _____ SANITARY 5508 STORM _____

CURB FROM PROPERTY LINE _____ PAVEMENT WIDTH _____

B.C. HYDRO _____ UNDERGROUND CONNECTION _____


B.C. TELEPHONE _____ UNDERGROUND CONNECTION _____

INLAND GAS _____

Information Sheets: _____

Comments: File: 1979 ASSESS - Margaret Andruschuk.

SITE PLAN N.T.S.

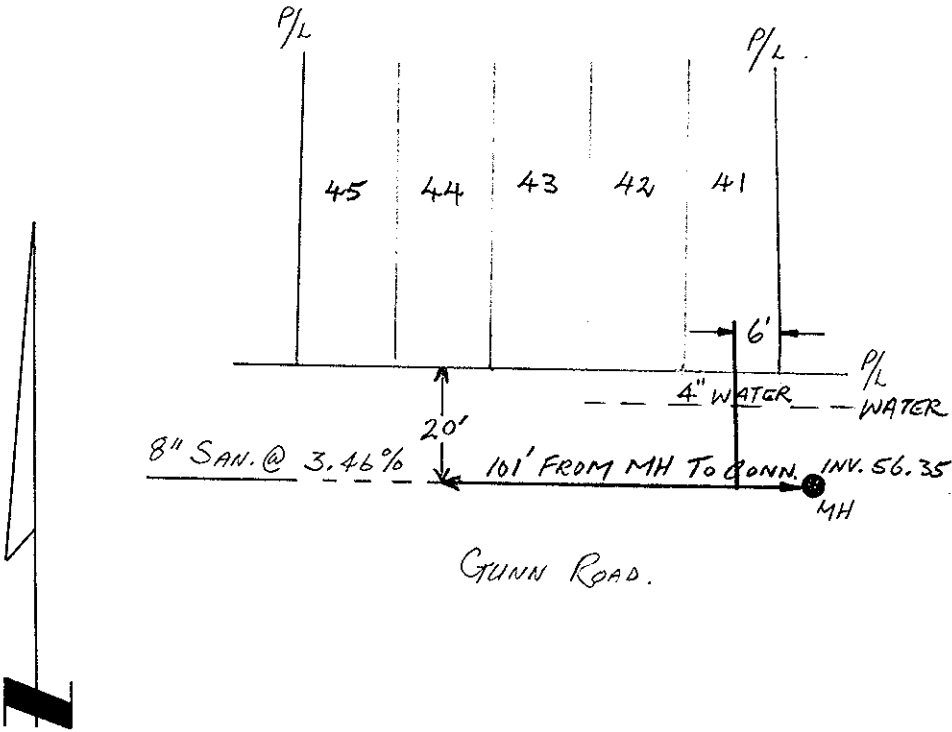

CUT @ P/L IS 8'