

**City of Prince George
HISTORY SHEET**

27
412
468

SHEET NUMBER _____ Roll Number _____

Legal: LOT'S 41-45 BLOCK 63 D.L. 629 PLAN 902

Address: 2623-2659 GUNN ROAD

Sanitary Connection: # 11243 SIZE 4" MATERIAL AC. INV. _____ CONNECTED

Water Connection # _____ SIZE _____ MATERIAL _____ METER _____ CONNECTED

Storm Connection: # _____ SIZE _____ MATERIAL _____ INV. _____ CONNECTED

Cash Receipt No's: WATER _____ SANITARY 5508 STORM _____

CURB FROM PROPERTY LINE _____ PAVEMENT WIDTH _____

B.C. HYDRO _____ UNDERGROUND CONNECTION _____


B.C. TELEPHONE _____ UNDERGROUND CONNECTION _____

INLAND GAS _____

Information Sheets: _____

Comments: F/O - 1979 ASSESS - Margaret Andrushek.

SITE PLAN N.T.S.

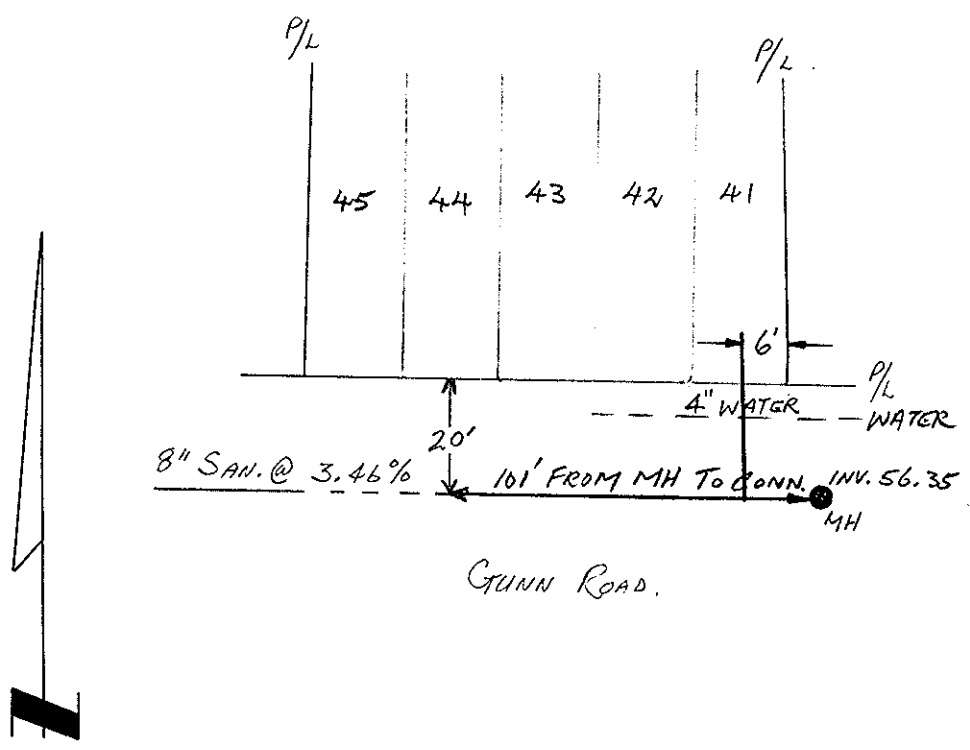

Cut @ P/L is 8'

GUNN ROAD.