

Civic Address: 7744 THOMPSON DR
 Legal Description: Lot: 28 District Lot: 1599 Plan: 15792

Service Type	Diameter (mm)	Material	Invert Elev @ Main (m)	Invert Elev @ Property Line (m)	Invert Elev @ Service End (m)	Distance into Property (m)	Installation Date
Sanitary	100	AC	-	-	-	-	JAN 1966
Water	20	COPPER	-	-	-	-	JAN 1984
Storm	N/A	-	-	-	-	-	-


Sanitary Service Connection Location Notes	Storm Service Connection Location Notes
Distance from downstream SMH #4567: 0.00m	Distance from downstream DMH #: N/A
Distance to upstream SMH #4567: 0.00m	Distance to upstream DMH #: N/A

Miscellaneous Utilities			
Power	Communications	Cable	Gas
BC Hydro	TELUS	Shaw Cable	FortisBC
Overhead Service	Overhead Service	Overhead Service	Underground Service

Installation By:	Unknown	Draft Date:	OCT 2024	Survey Date:	FEB 2024
------------------	---------	-------------	----------	--------------	----------

Comments:
 Sanitary Service is ~2.7m South from the North West corner of Lot 28. Water Service is ~3.5m South from the North West corner of Lot 28.

**NOT TO SCALE The information contained herein is for internal use only.
 Not to be relied on unless confirmed by site inspection and/or investigation.**

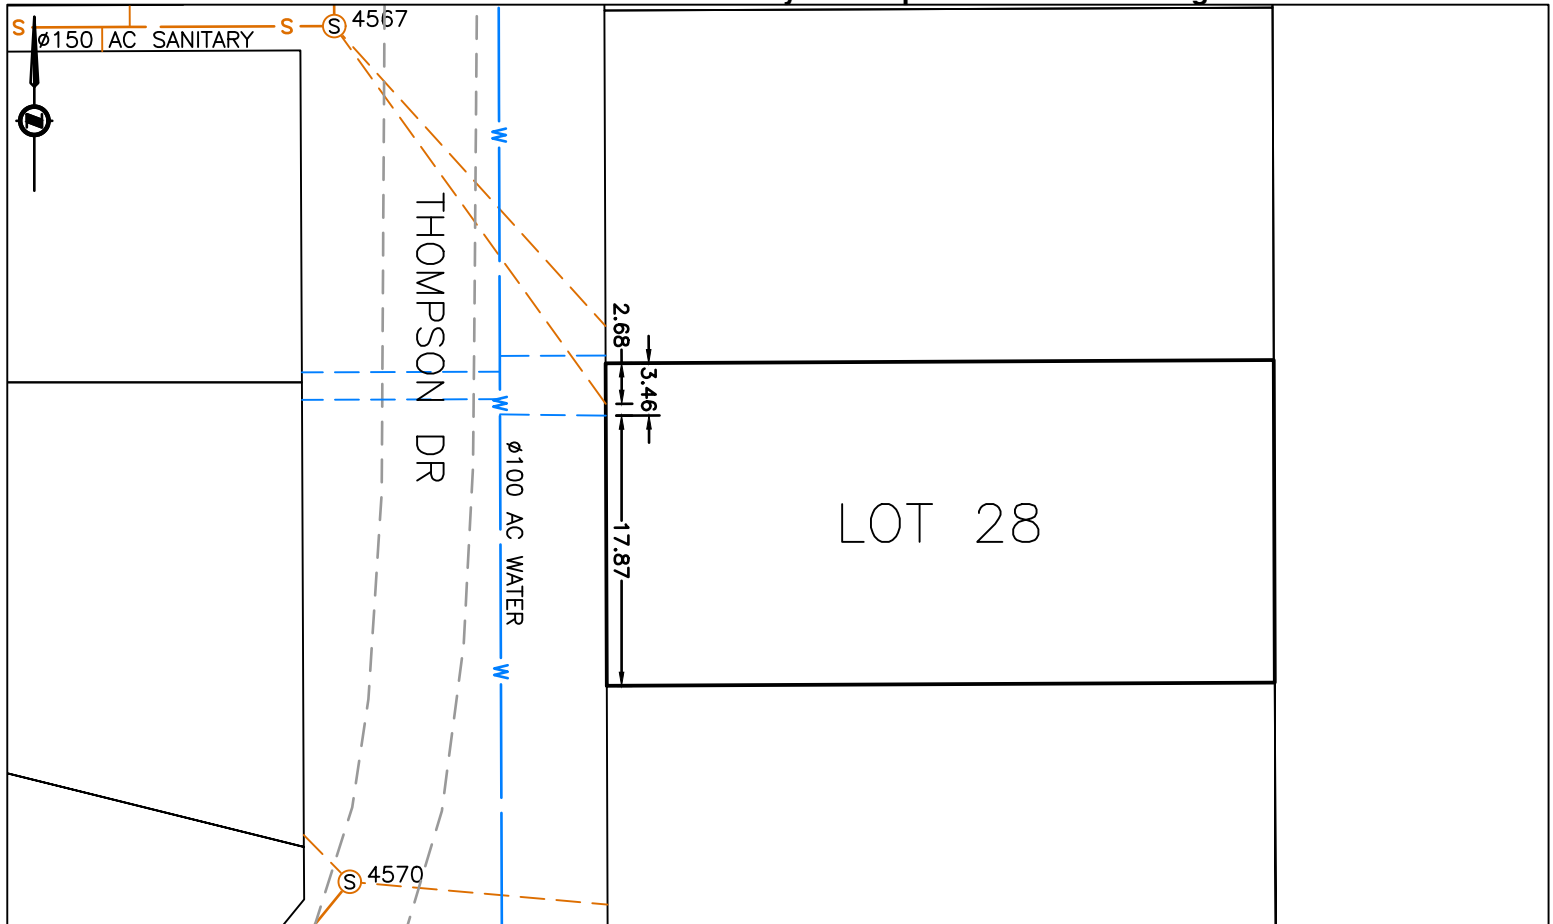

S	SANITARY MAIN	—S—	SANITARY SERVICE / CLEAN OUT
D	STORM MAIN	—D—	STORM SERVICE / CLEAN OUT
W	WATER MAIN	—W—	WATER SERVICE / CURB STOP
- - -	ROAD EDGE	- - -	FIRE HYDRANT LEAD, VALVE, HYDRANT
- - -	ENCUMBRANCE	- - -	