

**City of Prince George
HISTORY SHEET**

007050640
674

SHEET NUMBER

Roll Number

Legal: LOT'S 27 & 28 BLOCK 11 D.L. 932 PLAN 796

Address: 2231 OAK STREET

Sanitary Connection: # 6643 SIZE 100 mm MATERIAL A.C. INV. 567.082 CONNECTED

Water Connection # 6643 SIZE 20 mm MATERIAL CU. METER CONNECTED

Storm Connection: # SIZE MATERIAL INV. CONNECTED

Cash Receipt No's: WATER SANITARY 82 STORM

CURB FROM PROPERTY LINE 4.877 m PAVEMENT WIDTH 10.363 m

B.C. HYDRO 0/H UNDERGROUND CONNECTION



B.C. TELEPHONE 0/H UNDERGROUND CONNECTION

INLAND GAS 3.048 m FROM R

Information Sheets:

Comments: WITH THAW WIRE.

SITE PLAN N.T.S.

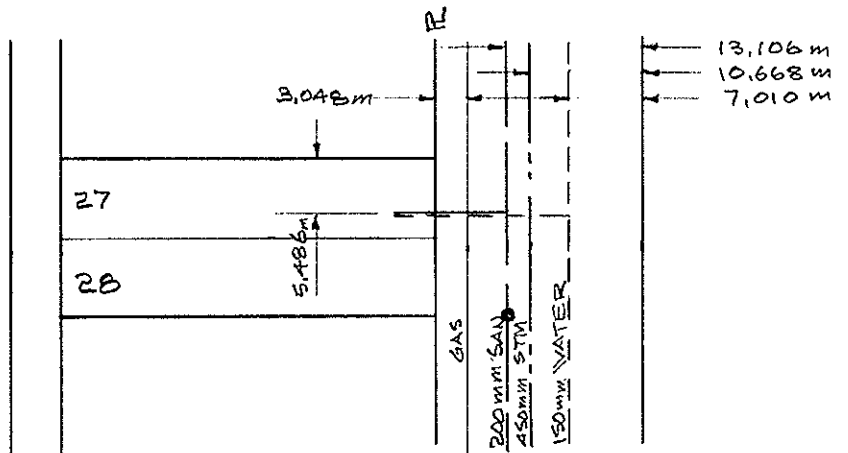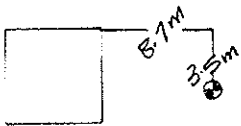

OAK ST.