

**City of Prince George
HISTORY SHEET**

007058896
007058900

SHEET NUMBER **Nº 2160** Roll Number

Legal: LOT'S 15, 16 BLOCK 331 D.L. 343 PLAN 1268

Address: 1974 UPLAND STREET

Sanitary Connection: # 7610 SIZE 4" MATERIAL A.C. INV. CONNECTED

Water Connection # 726 SIZE MATERIAL METER CONNECTED

Storm Connection: # SIZE MATERIAL INV. CONNECTED

Cash Receipt No's: WATER SANITARY 621 STORM

CURB FROM PROPERTY LINE PAVEMENT WIDTH

B.C. HYDRO UNDERGROUND CONNECTION

B.C. TELEPHONE UNDERGROUND CONNECTION


INLAND GAS

Information Sheets:

Comments:

THE INFORMATION CONTAINED HEREIN IS FOR INTERNAL
USE ONLY. NOT TO BE RELIED UPON UNLESS CONFIRMED
BY SITE INSPECTION AND/OR INVESTIGATION.

SITE PLAN N.T.S.

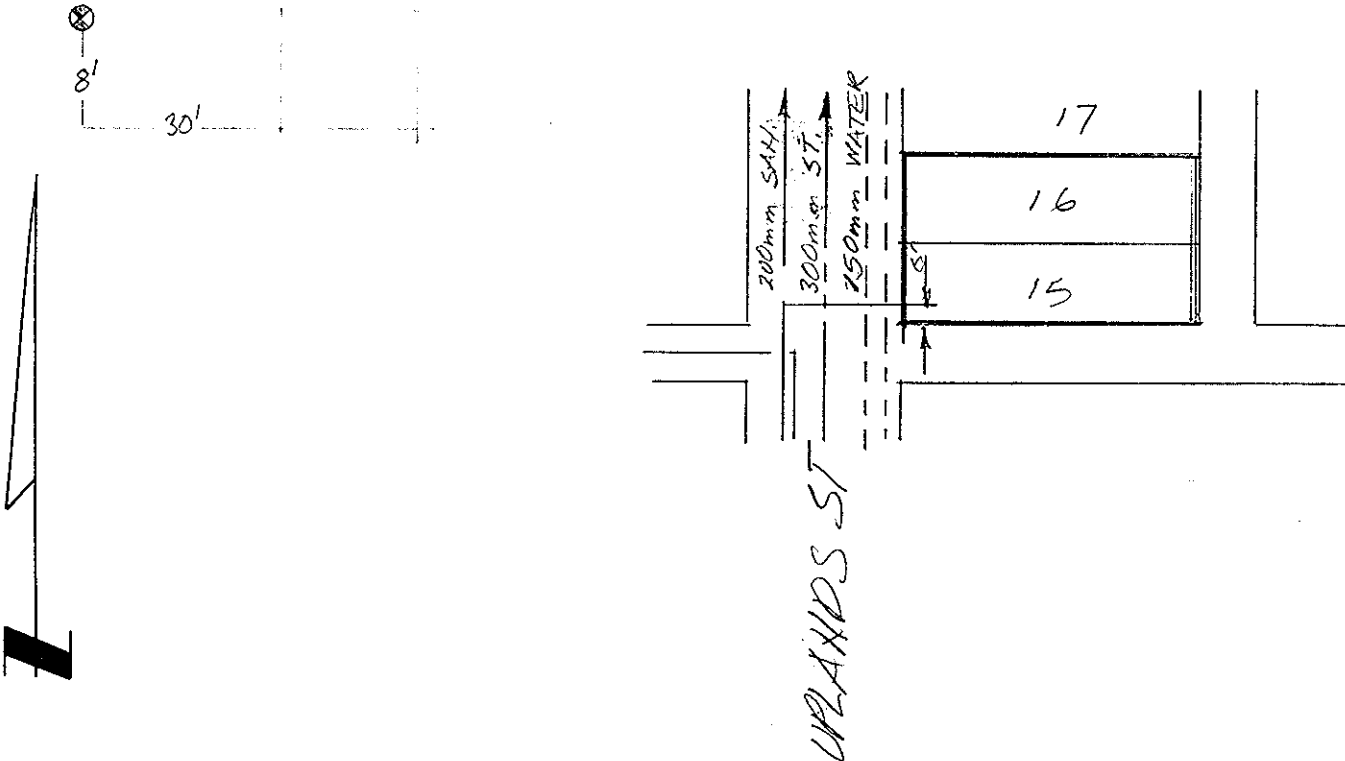

REPORT TO RECORDS

SEWER SERVICE INFORMATION

15-16/331

Lot No. _____ Block _____ D.L. _____


Address 1974 upland st

Size of Connection 100mm 150mm 200mm Other _____

Type of Connection Transite PVC Other _____

Type of Cap Transite Cast Iron

LOCATION SKETCH

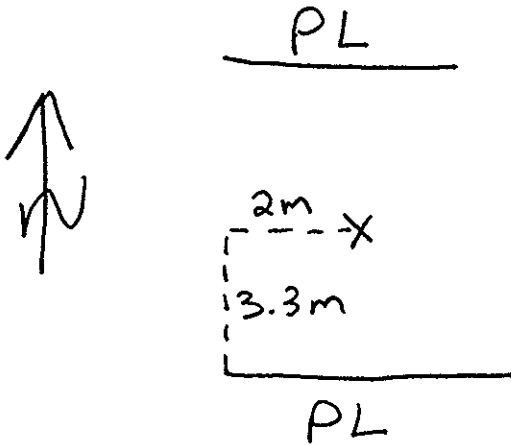

Field Location By JH Date April 19/00

Checked by Foreman - Sewer Division _____