

City of Prince George HISTORY SHEET

419
443

SHEET NUMBER

Roll Number

Legal: LOT'S 3-5 BLOCK 12 D.L. 932 PLAN 796

Address: 2214 - 2218 OAK STREET.

Sanitary Connection: # 2979 SIZE 100 mm MATERIAL A.C. INV. 567.390 CONNECTED

Water Connection # 5452 SIZE 20 mm MATERIAL CU. METER _____ CONNECTED

Storm Connection: # _____ SIZE _____ MATERIAL _____ INV. _____ CONNECTED

Cash Receipt No's: WATER _____ SANITARY _____ STORM _____

CURB FROM PROPERTY LINE 4.277 m PAVEMENT WIDTH 10.363 m


B.C. HYDRO 0/H UNDERGROUND CONNECTION _____

B.C. TELEPHONE 0/H UNDERGROUND CONNECTION _____


INLAND GAS 3.962 m FROM WEST SIDE OF OAK ST.

Information Sheets:

Comments: WITH THAW WIRE.

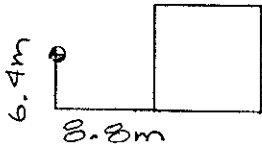

SITE PLAN N.T.S.

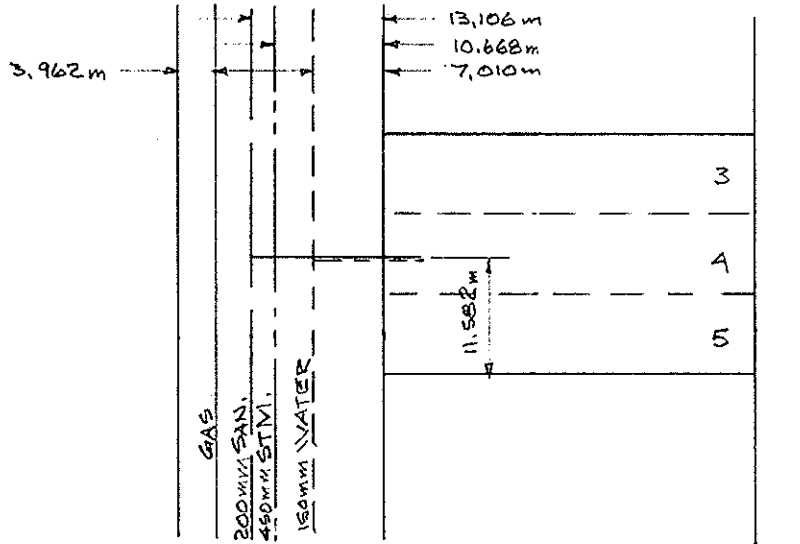

OAK ST.

