


D>

Lot Servicing

1450 TAYLOR DR
Block: V, Plan: 1268, DL: 343

PID: 007140827

SERVICE	SIZE	MATERIAL	INSTALLED DATE	LOCATION	DETAILS
WATER	20MM	CU	16-Jun-2005	19.6M S N PL	CASH RECEIPT NUMBER 100364
SANITARY	100MM	PVC	16-Jun-2005	20M S N PL	CLEANOUT YES
STORM	-----				NOT REQ'D

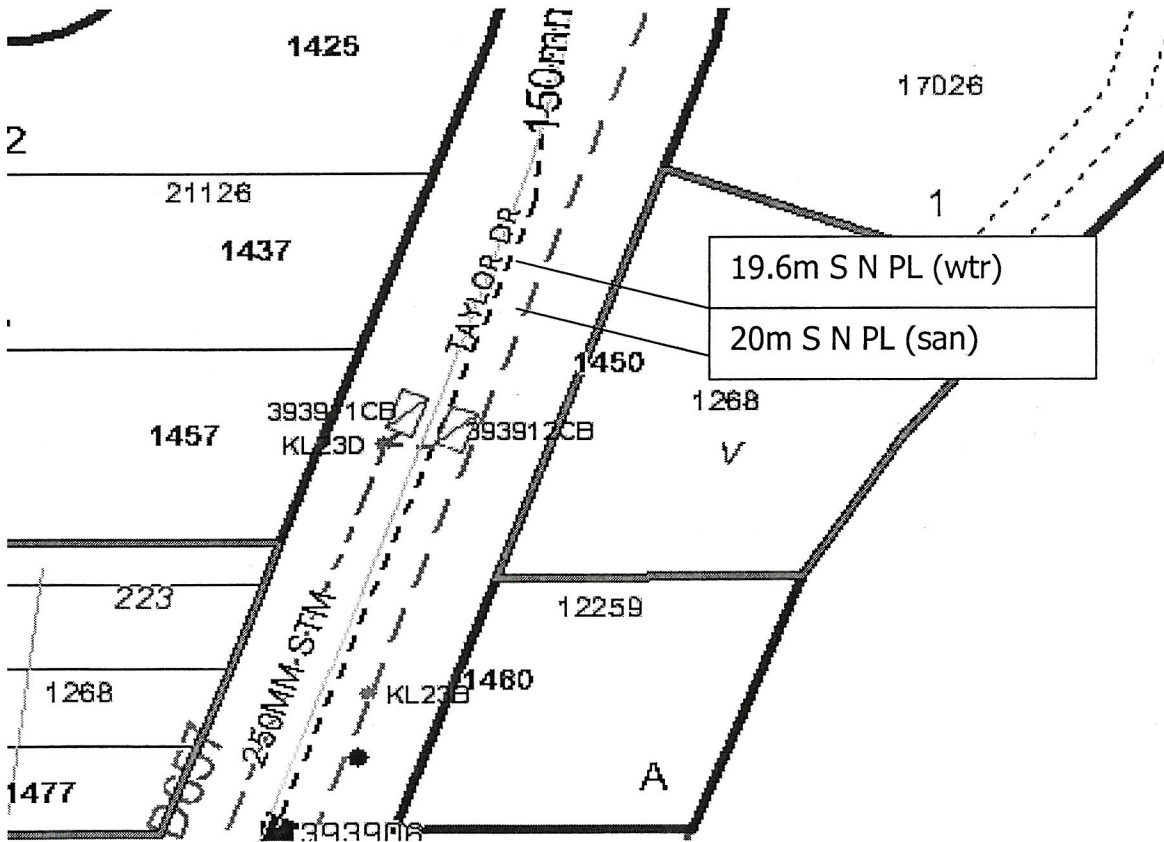

Accuracy not guaranteed unless confirmed by site inspection and/or investigation.
Connection location between main and property line only.