



City of Prince George
History Sheet

PID:	007213638
SD/MU:	
WO:	

Civic Address: 4890 North Meadow Crt
 Legal Description: Lot: 28 District Lot: 4050 Plan: 26344


Service Type	Diameter (mm)	Material	Invert Elev at main (m)	Invert Elev at property line (m)	Invert Elev at service end (m)	Distance into property (m)	Installation Date
Sanitary	100mm	PVC	-	610.17	-	-	January 1981
Water	20mm	Copper	-	-	-	-	January 1981
Storm	N/A	N/A	-	-	-	-	

Service Connection Location	Sanitary (m)	Storm (m)
100mm Sanitary saervice connected SMH1411	-	
Distance from downstream Stm MH - towards upstream Stm MH	-	

Power	Size	Communications	Size	Cable	Size	Gas	Size
BC Hydro	-	Telus	-	Shaw	-	FortisBC	-
Underground Service		Underground Service		Underground Service			

Installed by:	Survey Date:	-
Comments:		

NOT TO SCALE The information contained herein is for internal use only.
 Not to be relied on unless confirmed by site inspection and/or investigation.

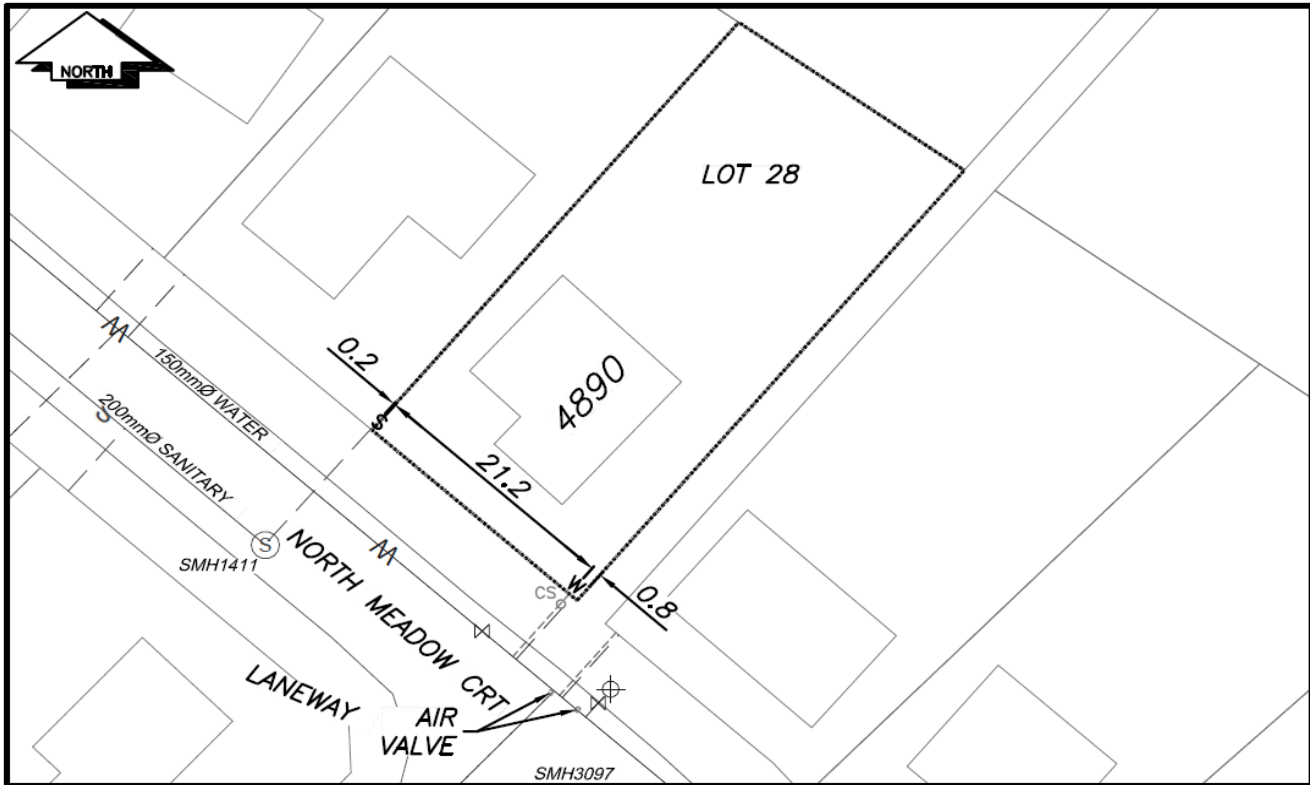

LEGEND:		
CS	CURB STOP	—W— WATER SERVICE
CO	CLEAN OUT	- - - - - SANITARY SERVICE
⊗	WATER VALVE	—G— GAS
		- - - - - ENCUMBRANCE
		⊗ FIRE HYDRANT
		⊗ STORM SERVICE

NOT TO SCALE