



City of Prince George
History Sheet

PID:	007214251
SD/MU:	
WO:	

Civic Address: 4818 North Meadow Rd

Legal Description: Lot: 37 District Lot: 4050 Plan: 26344


Service Type	Diameter (mm)	Material	Invert Elev at main (m)	Invert Elev at property line (m)	Invert Depth at service end (m)	Distance into property (m)	Installation Date
Sanitary	100mm	PVC	-	604.30	2.00	-	December 1980
Water	20mm	Copper	-	-	-	-	December 1980
Storm	N/A	N/A	-	-	-	-	

Service Connection Location				Sanitary (m)	Storm (m)
Distance from downstream San MH	1443	towards upstream San MH	1439	80.98	
Distance from downstream Stm MH	-	towards upstream Stm MH	-		

Power	Size	Communications	Size	Cable	Size	Gas	Size
BC Hydro	-	Telus	-	Shaw	-	FortisBC	-
Underground Service		Underground Service		Underground Service			

Installed by:		Survey Date:	-
Comments:	Wather and Sanitay services confirmed on June 19, 2019		

NOT TO SCALE The information contained herein is for internal use only.
Not to be relied on unless confirmed by site inspection and/or investigation.

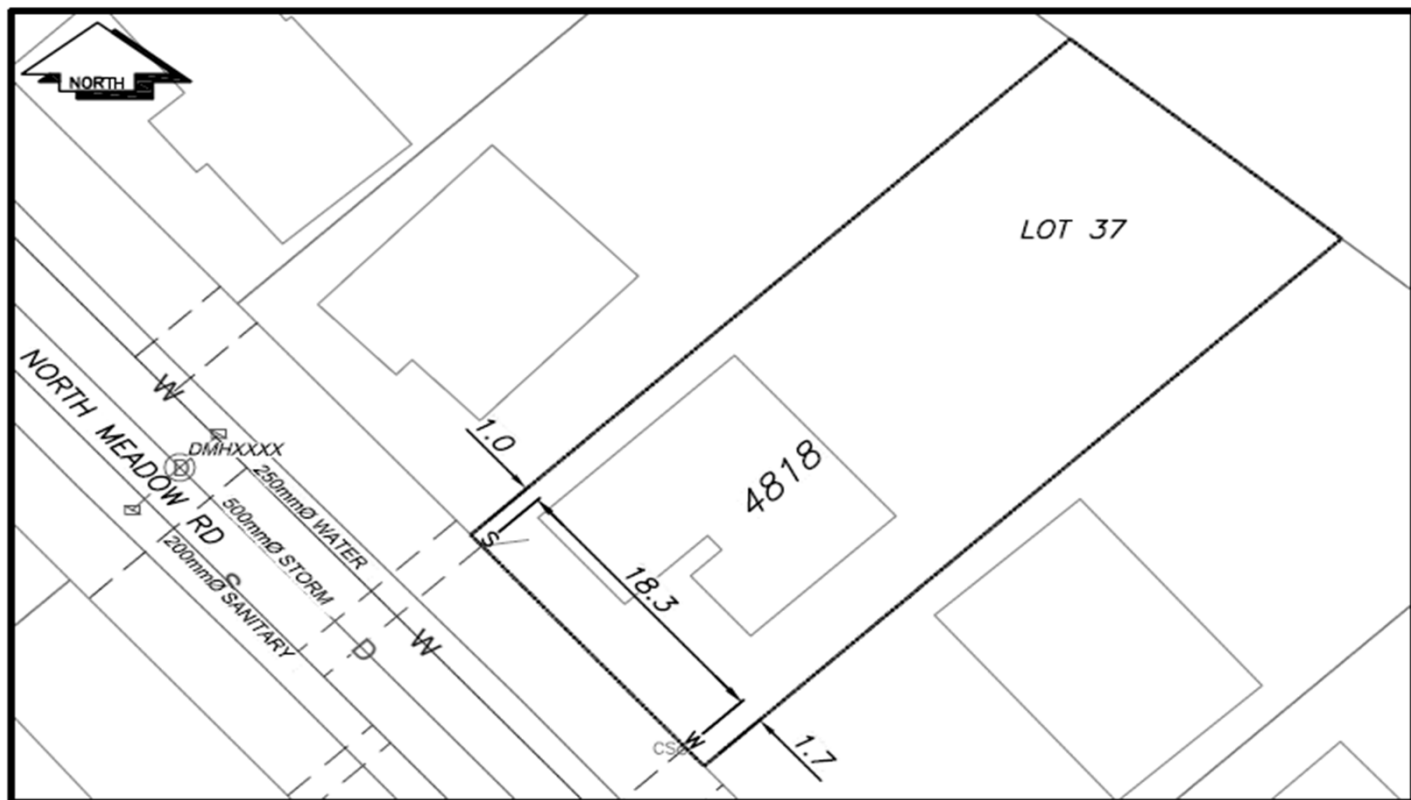

LEGEND:									
CS	CURB STOP	---W---	WATER SERVICE	---S---	SANITARY SERVICE	---G---	GAS	---O---	STORM SERVICE
CO	CLEAN OUT	---S---	SANITARY SERVICE	---G---	GAS	---O---	STORM SERVICE	---	ENCUMBRANCE
WV	WATER VALVE	⊗	FIRE HYDRANT						

NOT TO SCALE