



City of Prince George
History Sheet

PID:	007214405
MU:	101423
WO:	72932/ 72933

Civic Address: 4905 Meadowbrook Rd
 Legal Description: Lot: 53 District Lot: 4050 Plan: 26344


Service Type	Diameter (mm)	Material	Invert Elev at main (m)	Invert Elev at property line (m)	Invert Elev at service end (m)	Distance into property (m)	Installation Date
Sanitary	100mm	PVC	-	-	-	-	September 2013
Water	20mm	Copper	-	-	-	-	September 2013
Storm	N/A	N/A	-	-	-	-	

Service Connection Location	Sanitary (m)	Storm (m)
Service connected to San MH 1438	-	
Distance from downstream Stm MH - towards upstream Stm MH	-	

Power	Size	Communications	Size	Cable	Size	Gas	Size
BC Hydro	-	Telus	-	Shaw	-	FortisBC	-
Underground Service		Underground Service		Underground Service			

Installed by:	City of Prince George forces	Survey Date:	-
Comments:			

NOT TO SCALE The information contained herein is for internal use only.
Not to be relied on unless confirmed by site inspection and/or investigation.

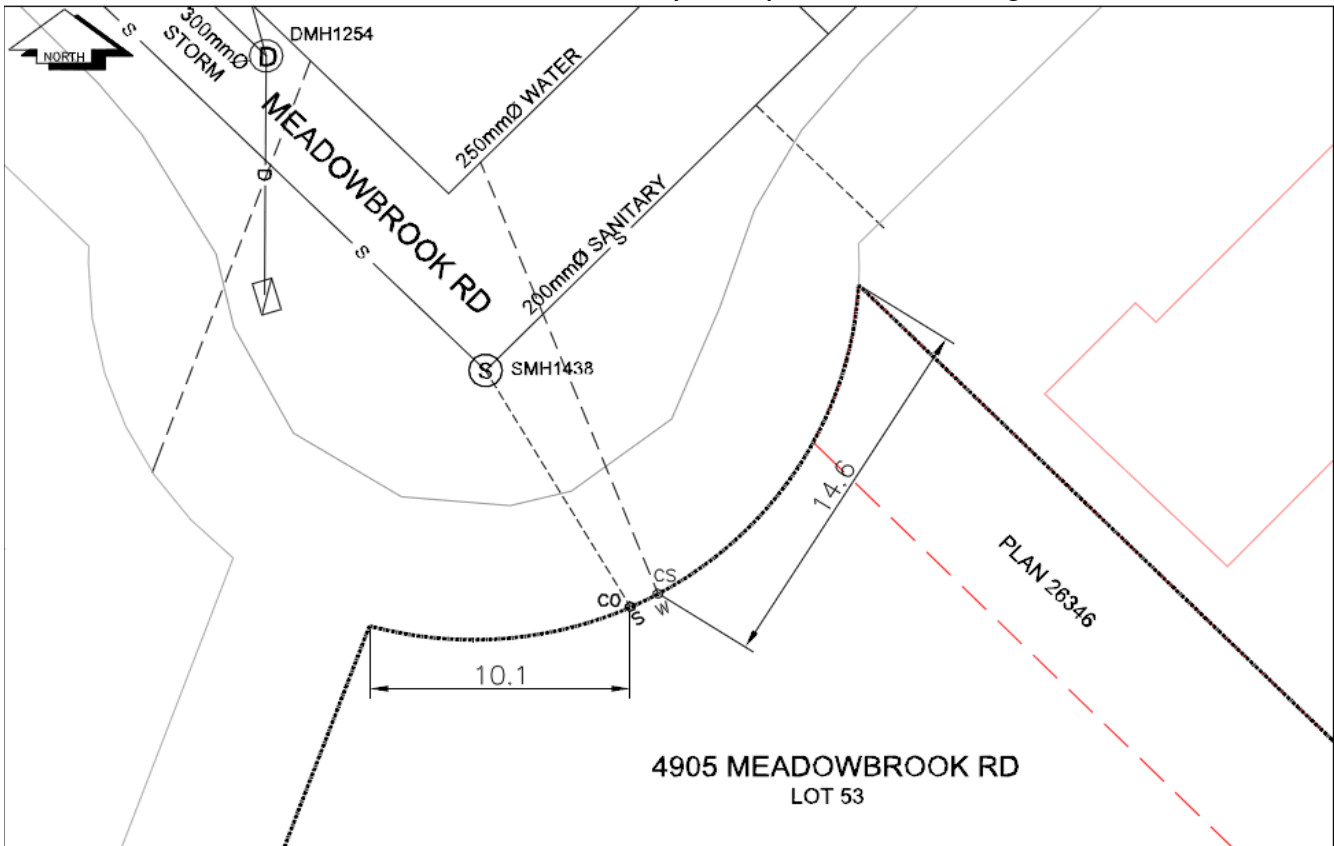

LEGEND:	CS	CURB STOP	---	W	WATER SERVICE	---	S	STORM SERVICE
	CO	CLEAN OUT	---	S	SANITARY SERVICE	---	⊗	WATER VALVE

NOT TO SCALE