



City of Prince George
History Sheet

PID:	007214618
SD/MU:	
WO:	

Civic Address: 3789 Fairburn Rd

Legal Description: Lot: 67 District Lot: 4050 Plan: 26344


Service Type	Diameter (mm)	Material	Invert Elev at main (m)	Invert Elev at property line (m)	Invert Depth at service end (m)	Distance into property (m)	Installation Date
Sanitary	100mm	PVC	-	604.95	2.30	-	December 1980
Water	20mm	Copper	-	-	-	-	December 1980
Storm	N/A	N/A	-	-	-	-	

Service Connection Location				Sanitary (m)	Storm (m)
Distance from downstream San MH	1409	towards upstream San MH	1389	24.85	
Distance from downstream Stm MH	-	towards upstream Stm MH	-		

Power	Size	Communications	Size	Cable	Size	Gas	Size
BC Hydro	-	Telus	-	Shaw	-	FortisBC	-
Overhead Service		Overhead Service		Overhead Service			

Installed by:		Survey Date:	-
Comments:	Water service location confirmed June 27, 2018		

NOT TO SCALE The information contained herein is for internal use only.
Not to be relied on unless confirmed by site inspection and/or investigation.

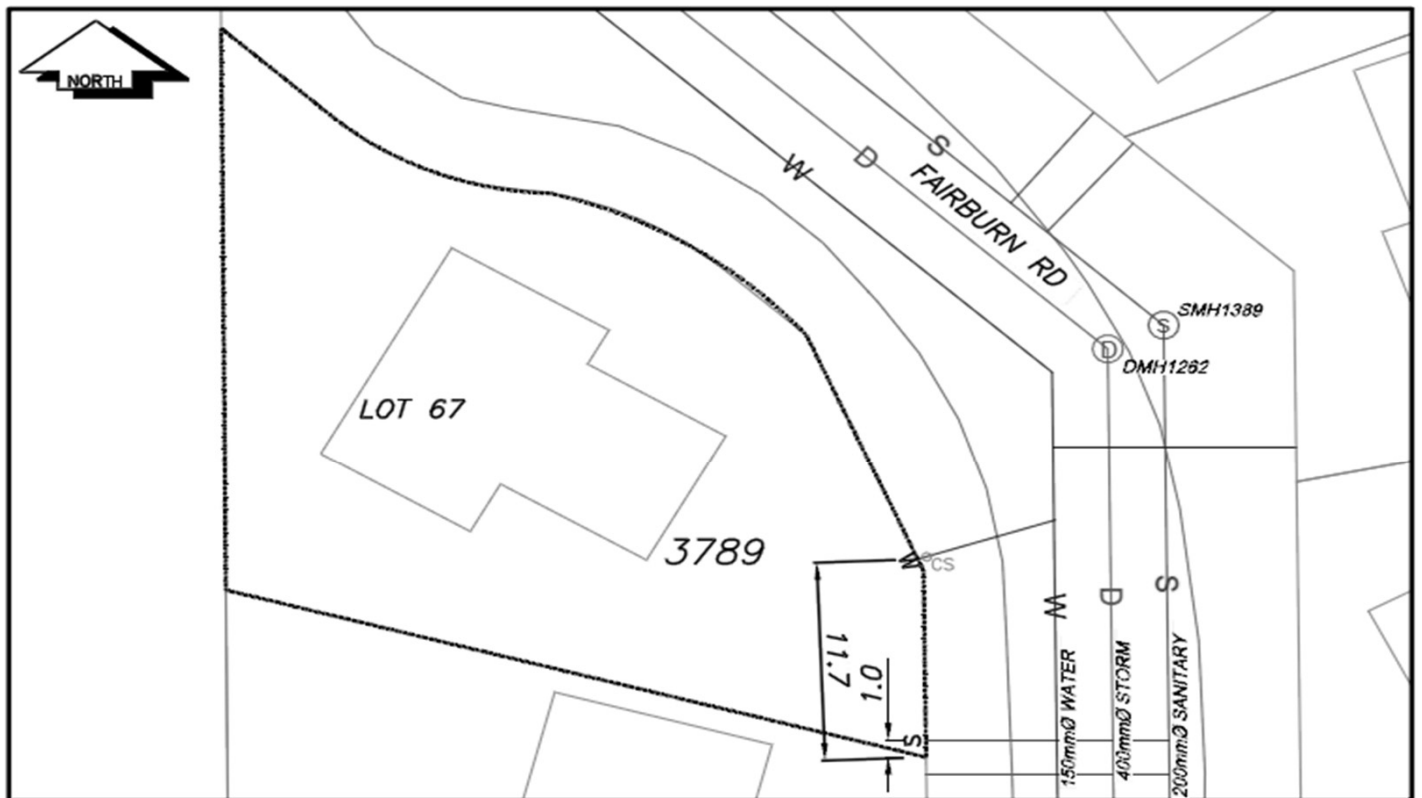

LEGEND:	
CS	CURB STOP
CO	CLEAN OUT
X	WATER VALVE
W	WATER SERVICE
S	SANITARY SERVICE
X	FIRE HYDRANT
D	STORM SERVICE
G	GAS
- - -	ENCUMBRANCE

NOT TO SCALE