

**City of Prince George
HISTORY SHEET**

007 390033

SHEET NUMBER **Nº 4033** Roll Number

Legal: LOT'S **A** BLOCK D.L. 343 PLAN 26075

Address: **885 SECOND AVE. - 7th Floor**

Sanitary Connection: # **2084** SIZE MATERIAL INV. CONNECTED

Water Connection # **24** SIZE **3/4"** MATERIAL **Cu** METER CONNECTED

Storm Connection: # SIZE MATERIAL INV. CONNECTED

Cash Receipt No's: WATER SANITARY **00511** STORM

CURB FROM PROPERTY LINE **10'** PAVEMENT WIDTH **60**


B.C. HYDRO **OH** UNDERGROUND CONNECTION

B.C. TELEPHONE **OH** UNDERGROUND CONNECTION

INLAND GAS **In pipe 28' of main**

Information Sheets:

Comments: **LOT A IS SOUTHWEST CORNER WITH LOT 192 BLK 40 ON 5/13/1954
AND THERE ARE ONLY CONNECTIONS SHOWN TO SERVE ALL THREE LOTS.**

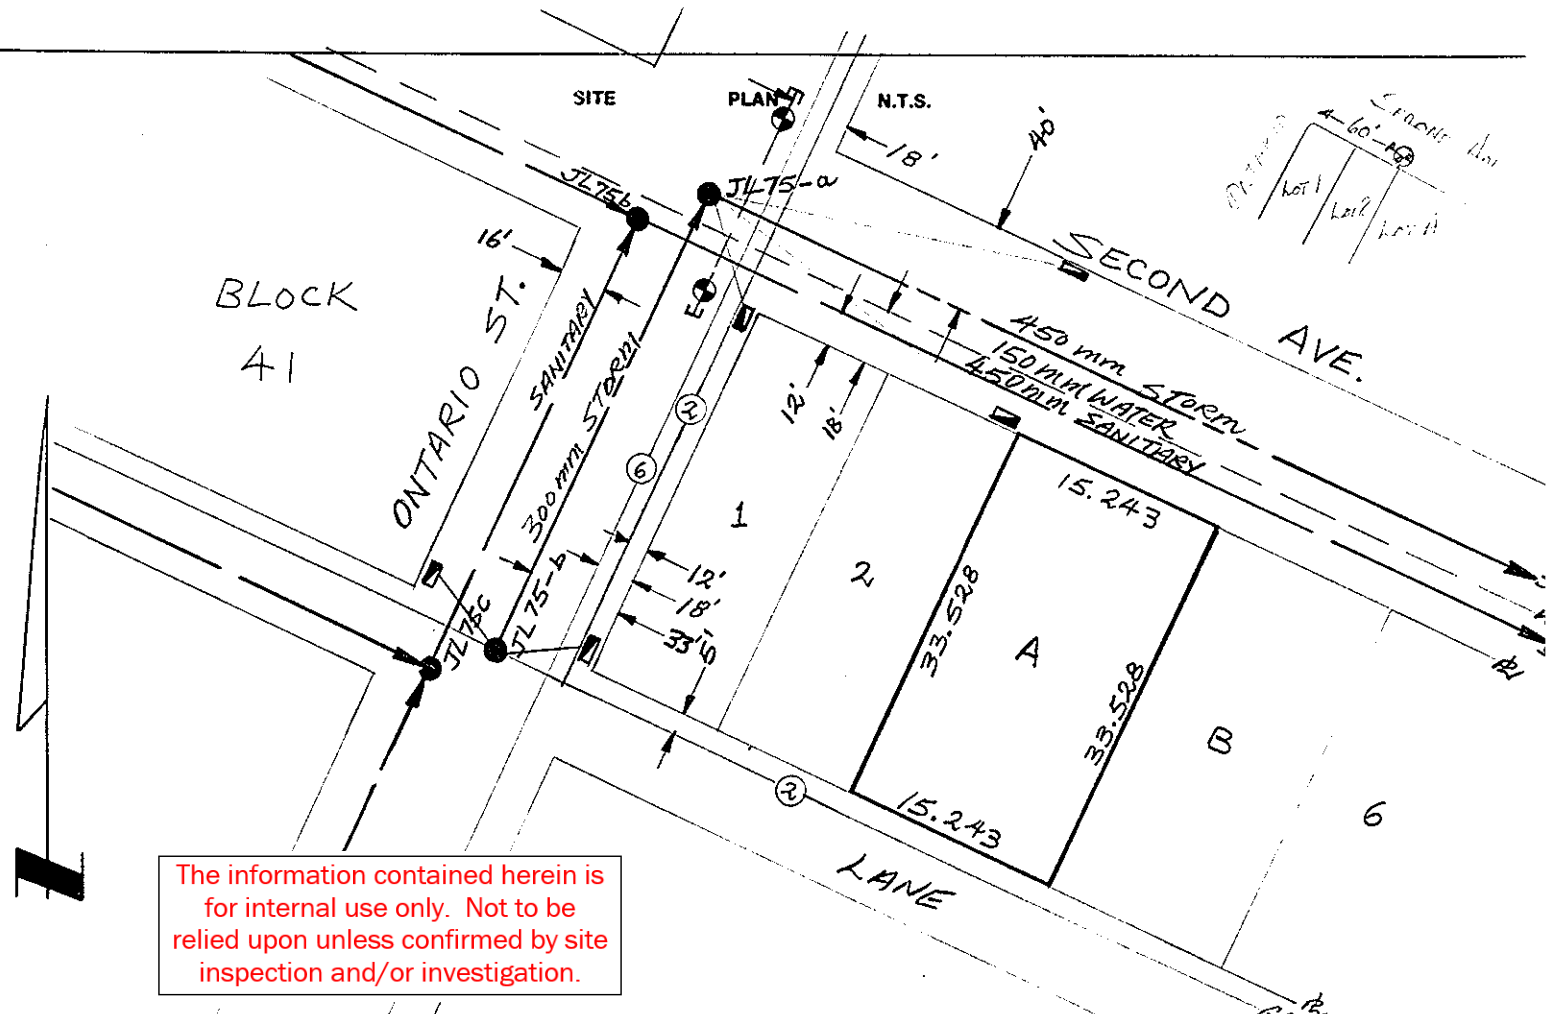

The information contained herein is for internal use only. Not to be relied upon unless confirmed by site inspection and/or investigation.