



City of Prince George  
**History Sheet**

PID:	007431651
SD/MU:	
WO:	

Civic Address: 1551 - 1535 Ogilvie St  
Legal Description: Lot: A District Lot: 936 Plan: 25949


Service Type	Diameter (mm)	Material	Invert Elev at main (m)	Depth of cut at property line (m)	Invert Elev at service end (m)	Distance into property (m)	Installation Date
Sanitary	100mm	PVC	601.09	1.40	603.29	3.00	April 1968
Water	20mm	Copper	-	-	-	-	July 1964
Water	20mm	Copper	-	-	-	-	July 1964
Storm	N/A	N/A	-	-	-	-	

Service Connection Location				Sanitary (m)	Storm (m)
Distance from downstream San MH	829	towards upstream San MH	836	74.90	
Distance from downstream Stm MH	-	towards upstream Stm MH	-		

Power	Size	Communications	Size	Cable	Size	Gas	Size
BC Hydro	-	Telus	-	Shaw	-	FortisBC	-
Overhead Service		Overhead Service		Overhead Service			

Installed by:		Survey Date:	-
Comments:	Water service locations and sizes confirmed by City forces on February 20, 2013		

**NOT TO SCALE The information contained herein is for internal use only.  
Not to be relied on unless confirmed by site inspection and/or investigation.**

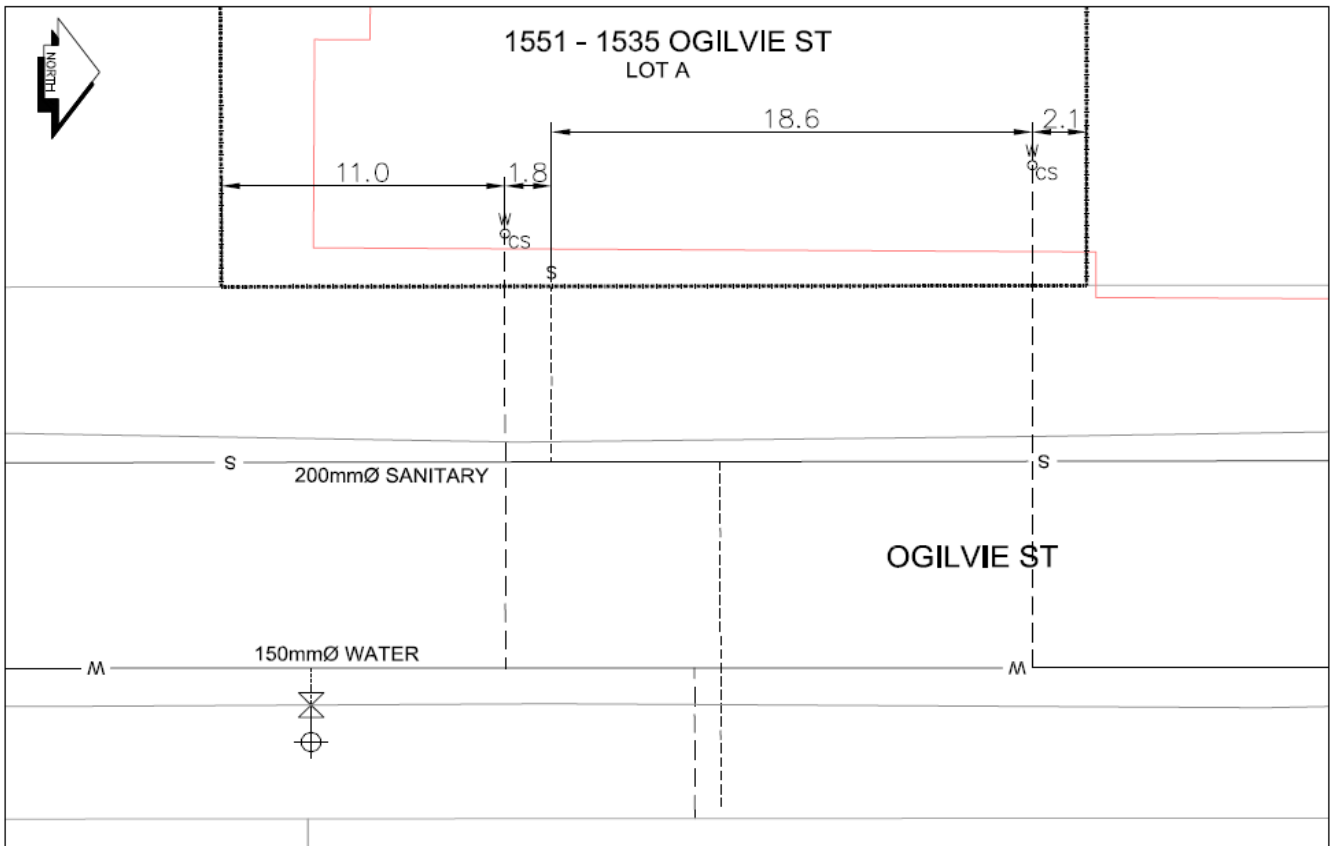

LEGEND:

CS	CURB STOP	---	W	WATER SERVICE	---	S	STORM SERVICE
CO	CLEAN OUT	---	S	SANITARY SERVICE	---	⊗	WATER VALVE

**NOT TO SCALE**