



City of Prince George  
**History Sheet**

PID:	007526865
SD/MU:	
WO:	

Civic Address: 2759 Michener Cres

Legal Description: Lot: 11 District Lot: 8175 Plan: 17631


Service Type	Diameter (mm)	Material	Invert Elev at main (m)	Invert Elev at property line (m)	Invert Depth at service end (m)	Distance into property (m)	Installation Date
Sanitary	100mm	AC	-	589.94	2.54	-	December 1966
Water	20mm	Copper	-	-	-	-	December 1966
Storm	N/A	N/A	-	-	-	-	

Service Connection Location				Sanitary (m)	Storm (m)
Distance from downstream San MH	3830	towards upstream San MH	3833	16.90	
Distance from downstream Stm MH	-	towards upstream Stm MH	-		

Power	Size	Communications	Size	Cable	Size	Gas	Size
BC Hydro	-	Telus	-	Shaw	-	FortisBC	-
Underground Service		Underground Service		Underground Service			

Installed by:		Survey Date:	-
Comments:	Water and Sanitary service confirmed July 2017		

**NOT TO SCALE** The information contained herein is for internal use only.  
Not to be relied on unless confirmed by site inspection and/or investigation.

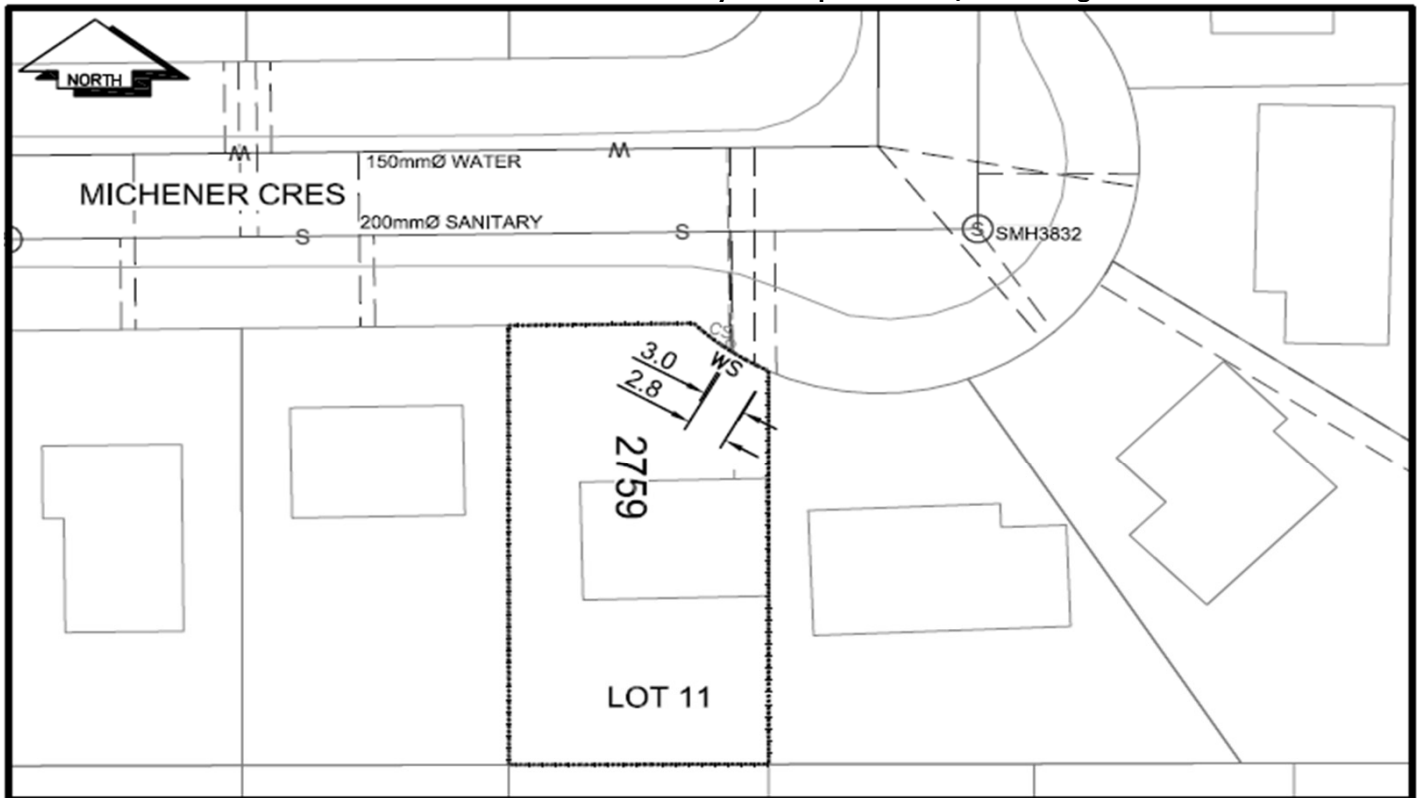

LEGEND:	
CS <sup>o</sup>	CURB STOP
CO <sup>o</sup>	CLEAN OUT
⊗	WATER VALVE
---	WATER SERVICE
---	SANITARY SERVICE
⊗	FIRE HYDRANT
---	STORM SERVICE
---	GAS
---	ENCUMBRANCE

**NOT TO SCALE**