

City of Prince George HISTORY SHEET

SHEET NUMBER

Roll Number 009552572

Legal: LOT'S 62 BLOCK — D.L. 2507 PLAN 16227

Address: 1102 CLUGULZ AVE

Sanitary Connection: # 5220 SIZE 100mm MATERIAL A.C. INV. 602.487 CONNECTED

Water Connection # 6220 SIZE 20mm MATERIAL CU. METER CONNECTED

Storm Connection: # _____ SIZE _____ MATERIAL _____ INV. _____ CONNECTED

Cash Receipt No's: WATER _____ SANITARY _____ STORM _____

CURB FROM PROPERTY LINE 4.877m PAVEMENT WIDTH 10.363m

B.C. HYDRO N/A UNDERGROUND CONNECTION



B.C. TELEPHONE N/A UNDERGROUND CONNECTION

INLAND GAS 3.657m FROM R.

Information Sheets:

Comments:

**THE INFORMATION CONTAINED HEREIN IS FOR INTERNAL USE ONLY.
NOT TO BE RELIED UPON UNLESS CONFIRMED BY SITE INSPECTION AND/OR INVESTIGATION**

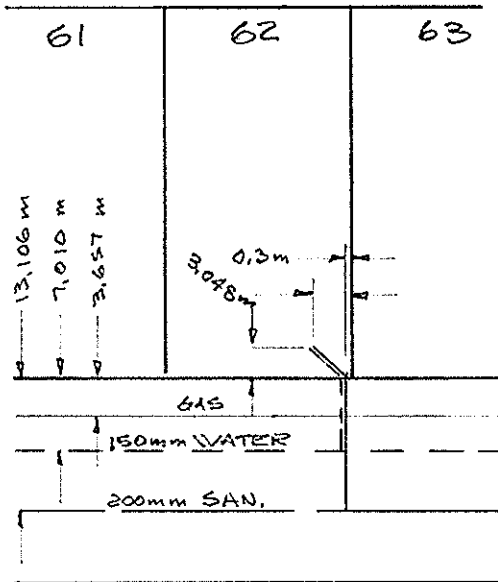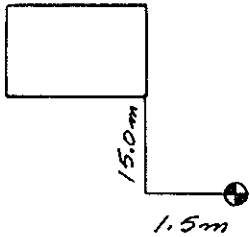

CLUGULZ AVE.

