

**City of Prince George
HISTORY SHEET**

SHEET NUMBER

Roll Number 007552581

Legal: LOT'S 3 BLOCK D.L. 753 PLAN 16085

Address: 2960 NOTRE DAME

Sanitary Connection: # SIZE MATERIAL INV. CONNECTED

Water Connection # SIZE 20mm MATERIAL CU METER CONNECTED

Storm Connection: # SIZE MATERIAL INV. CONNECTED

Cash Receipt No's: WATER SANITARY STORM

CURB FROM PROPERTY LINE PAVEMENT WIDTH


B.C. HYDRO UNDERGROUND CONNECTION

B.C. TELEPHONE UNDERGROUND CONNECTION

INLAND GAS

Information Sheets:

Comments:

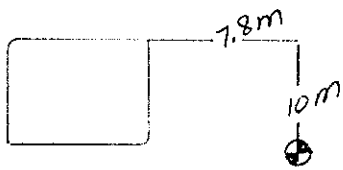

SITE PLAN N.T.S.

