

City of Prince George HISTORY SHEET

SI

SHEET NUMBER **5451** Roll Number **007 558 163**

Legal: LOT'S **A** BLOCK **2508** PLAN **25445**

Address: **4001 15th AVE. (I.C.B.C.)**

Sanitary Connection: # **8954** SIZE **4"** MATERIAL **AC** INV. **1972.76** CONNECTED

Water Connection # **8954** SIZE **4"** MATERIAL **CAST.** METER **CONNECTED**

Storm Connection: # **452** SIZE **300mm 12"** MATERIAL **V.I.T.** INV. **1969.12** CONNECTED

Cash Receipt No's: WATER **12102** SANITARY **12102** STORM **12102**

CURB FROM PROPERTY LINE PAVEMENT WIDTH


B.C. HYDRO **O.H.** UNDERGROUND CONNECTION

B.C. TELEPHONE **U.G.** UNDERGROUND CONNECTION

INLAND GAS **AS SHOWN**

Information Sheets:

Comments:

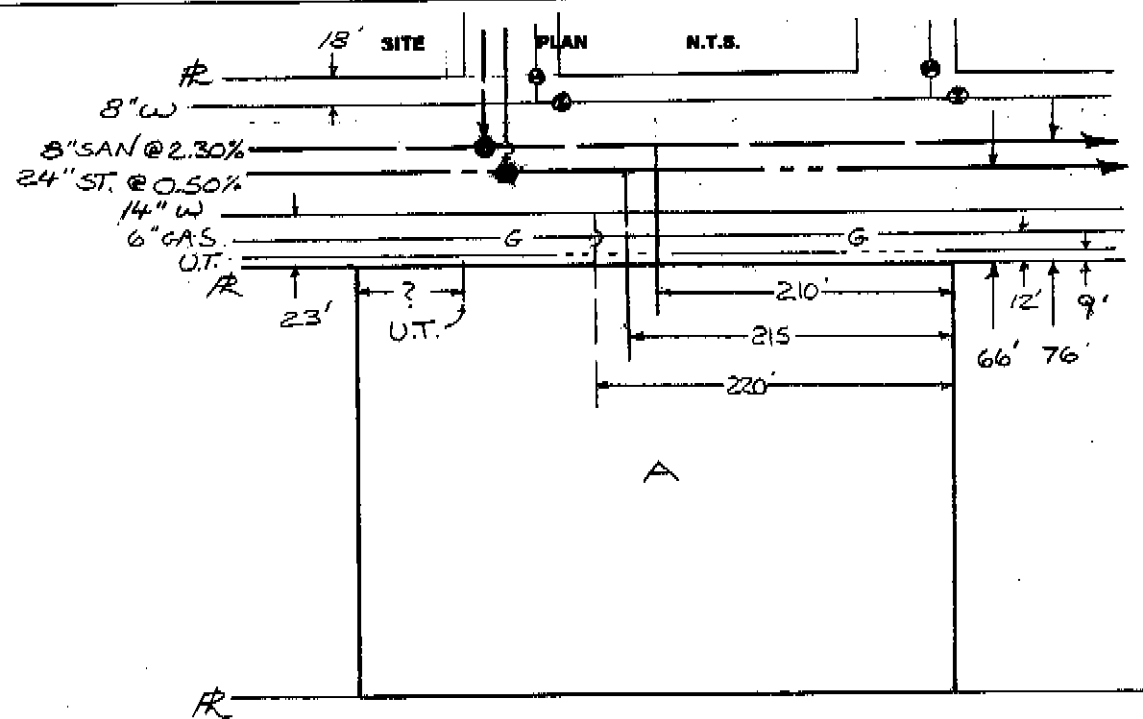

REM. LOT 2