

City of Prince George
HISTORY SHEET

SHEET NUMBER

PID # 007-577-206

Legal: LOT'S 5 BLOCK 3 D.L. 8178 PLAN 16808

Address: 229 LAUREL CRES.

Sanitary Connection: # 6225 SIZE 100 mm MATERIAL A.C. INV. 587.260 CONNECTED

Water Connection: # 6225 SIZE 20 mm MATERIAL C.U. METER CONNECTED

Storm Connection: # SIZE mm MATERIAL INV. CONNECTED

Cash Receipt No's: WATER SANITARY STORM

CURB FROM PROPERTY LINE 4.572 m PAVEMENT WIDTH 9.144 m

B.C. HYDRO U/G UNDERGROUND CONNECTION



B.C. TELEPHONE U/G UNDERGROUND CONNECTION

INLAND GAS 3.048 m FROM NORTH SIDE OF LAUREL CRES.

Information Sheets:

Comments: WITH THAW WIRE.

THE INFORMATION CONTAINED HEREIN IS FOR INTERNAL USE ONLY.
NOT TO BE RELIED UPON UNLESS CONFIRMED BY SITE INSPECTION AND/OR INVESTIGATION

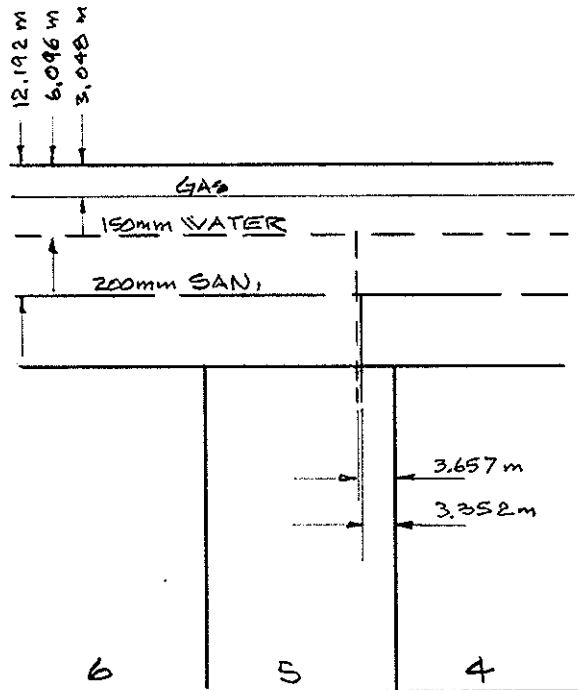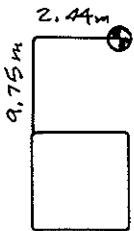

LAUREL CRES.

