


## Lot Servicing

1487 CONNAUGHT DR

PID: 007577532 007577524

**Lot: 22, Block: 265, Plan: 1268, DL: 343**

SERVICE	SIZE	MATERIAL	INSTALLED DATE	LOCATION	DETAILS
WATER	20MM	CU	13-Aug-1959	FR SW COR LOT 32 1.6M W	CONNECTION NUMBER 470
SANITARY	UNKNOWN	UNKNOWN		0.914M N OF SW COR PL	CONNECTION # 1296

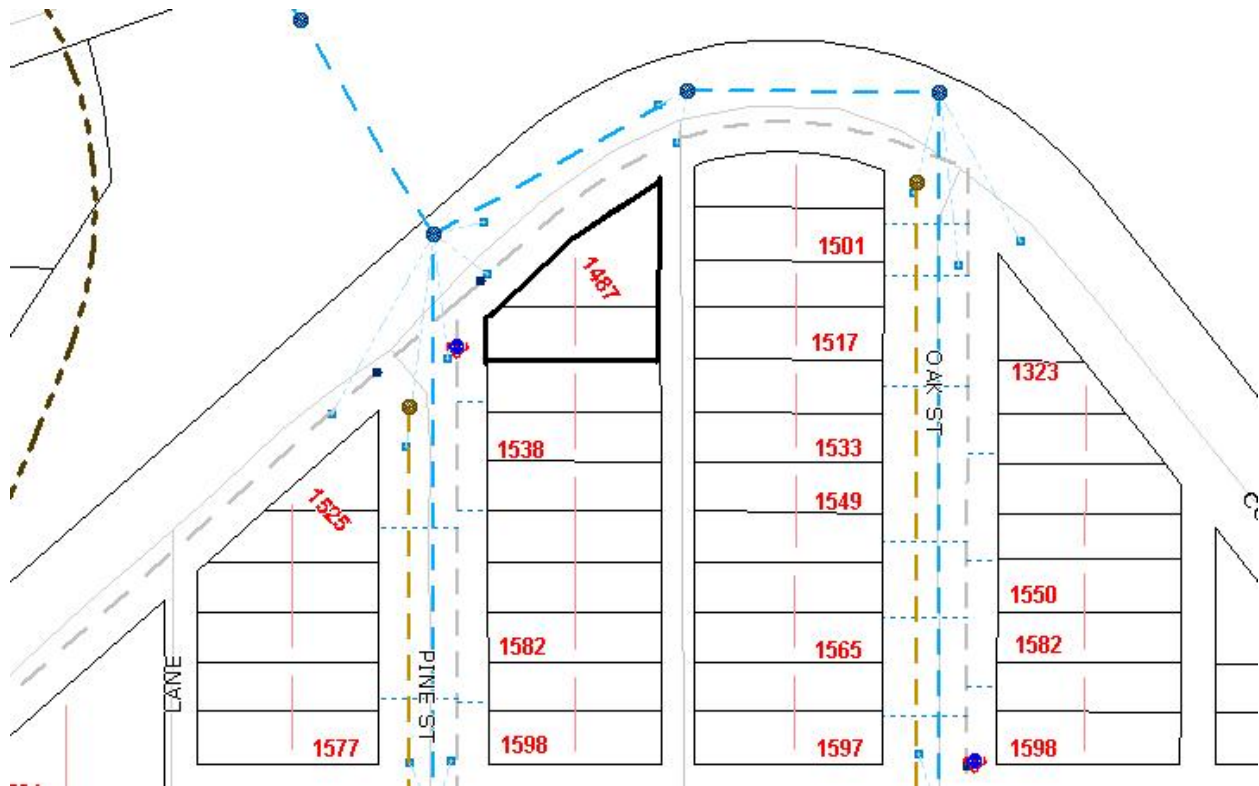

Accuracy not guaranteed unless confirmed by site inspection and/or investigation.  
 Connection location between main and property line only.