


Lot Servicing

1487 CONNAUGHT DR

PID: 007577532 007577524

Lot: 22, Block: 265, Plan: 1268, DL: 343

| SERVICE | SIZE | MATERIAL | INSTALLED DATE | LOCATION | DETAILS |
|----------|---------|----------|----------------|-------------------------|-----------------------|
| WATER | 20MM | CU | 13-Aug-1959 | FR SW COR LOT 32 1.6M W | CONNECTION NUMBER 470 |
| SANITARY | UNKNOWN | UNKNOWN | | 0.914M N OF SW COR PL | CONNECTION # 1296 |

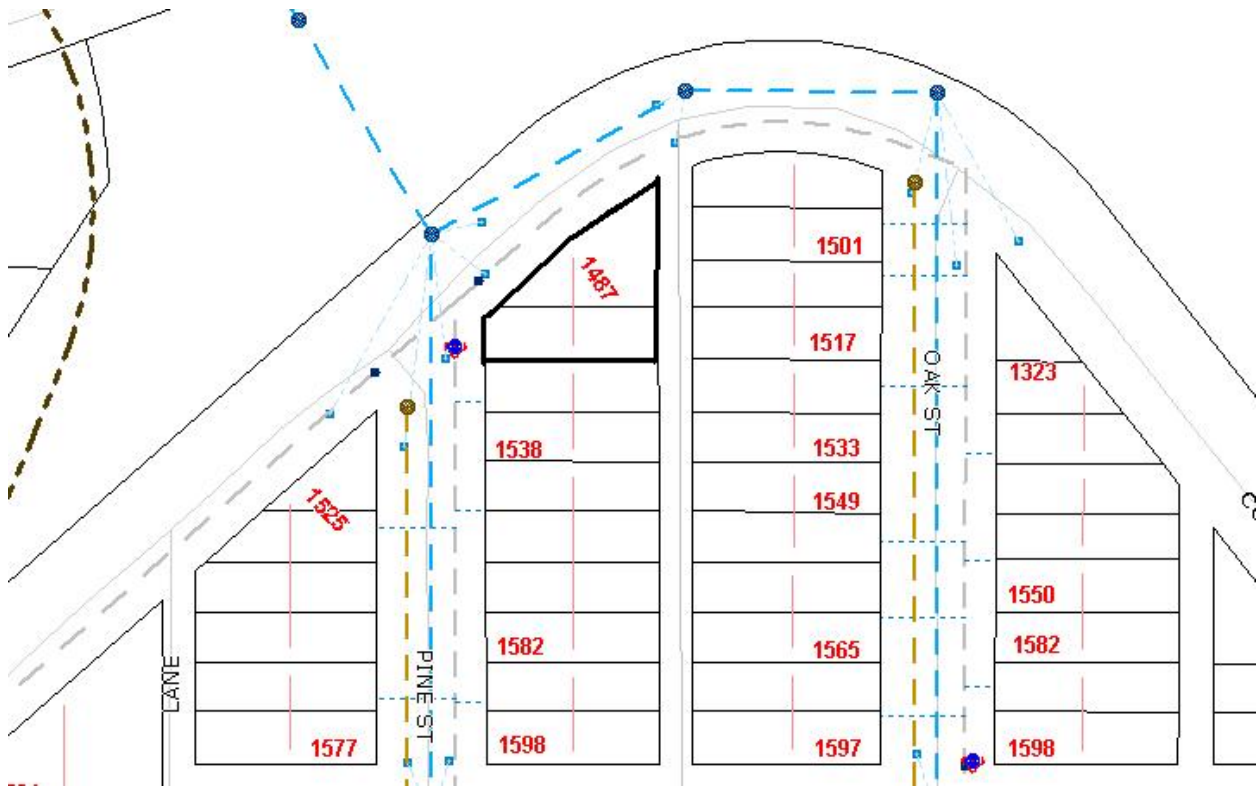

Accuracy not guaranteed unless confirmed by site inspection and/or investigation.
Connection location between main and property line only.