



City of Prince George  
**History Sheet**

PID:	007578270
SD/MU:	
WO:	

Civic Address: 6170 Acadia Pl  
 Legal Description: Lot: 2 District Lot: 754 Plan: 20922


Service Type	Diameter (mm)	Material	Invert Elev at main (m)	Invert Elev at property line (m)	Invert Elev at service end (m)	Distance into property (m)	Installation Date
Sanitary	100mm	PVC	-	-	-	7.40	January 1981
Water	20mm	Copper	-	-	-	-	January 1981
Storm	N/A	N/A	-	-	-	-	

Service Connection Location				Sanitary (m)	Storm (m)
Distance from downstream San MH	3800	towards upstream San MH	3798	31.20	
Distance from downstream Stm MH	-	towards upstream Stm MH	-		

Power	Size	Communications	Size	Cable	Size	Gas	Size
BC Hydro	-	Telus	-	Shaw	-	FortisBC	-
Overhead Service		Overhead Service		Overhead Service			

Installed by:	Survey Date:	-
Comments: Location confirmed March 2013. Sanitary clean out installed March 2013.		

**NOT TO SCALE** The information contained herein is for internal use only.  
 Not to be relied on unless confirmed by site inspection and/or investigation.

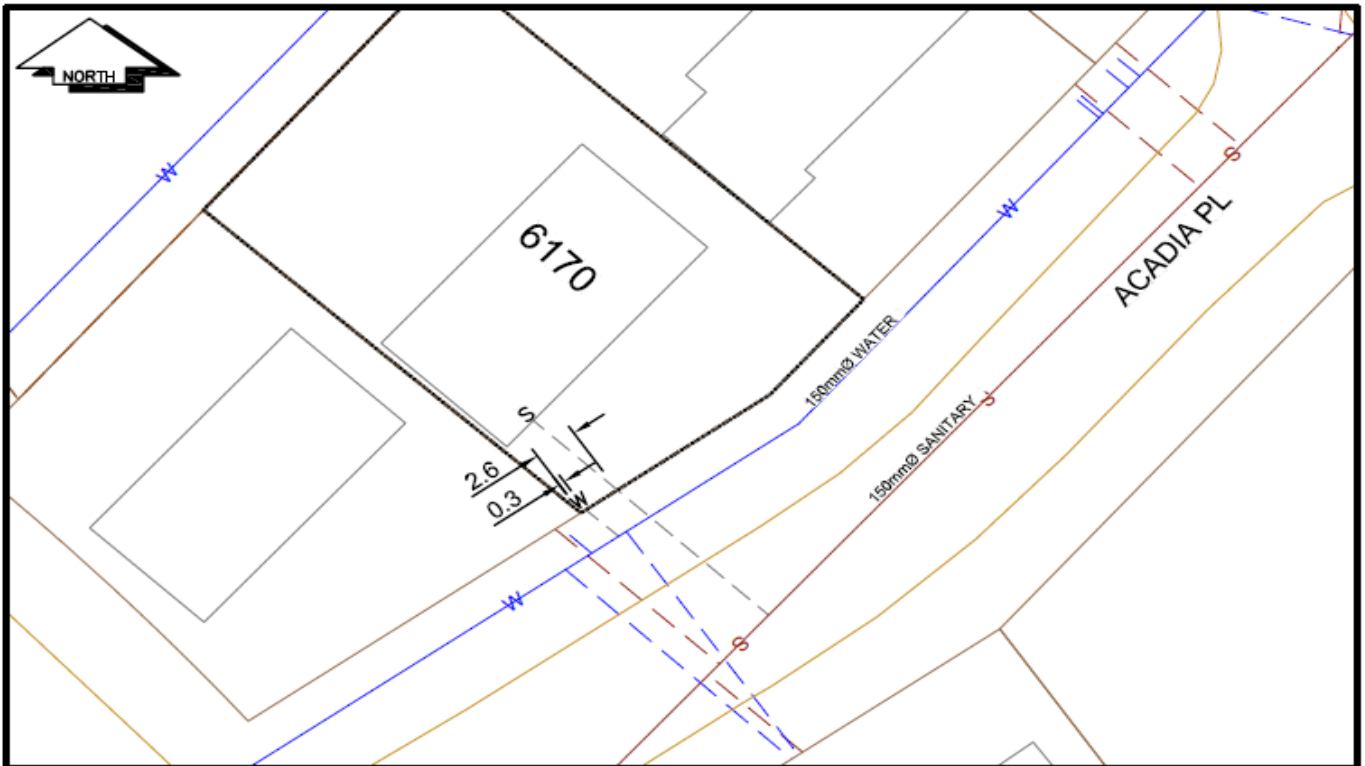

LEGEND:	CS <sup>o</sup> CURB STOP	---> WATER SERVICE	---o--- STORM SERVICE
	CO <sup>o</sup> CLEAN OUT	-s- SANITARY SERVICE	-G- GAS

**NOT TO SCALE**