
City of Prince George HISTORY SHEET

SHEET NUMBER		· · · · · · · · · · · · · · · · · · ·					Roll	l Number <i>CO9590372</i>
Legal:	LOT'S	77	вьоск			D.L. 2	2433	PLAN 22464
Address:		7394	PEARL DZ					
Sanitary Con	nection	: #	SłZE	4"	MATERIAL	Puc.	INV.	CONNECTED
Water Conne	ction #		SIZE	3/4"	MATERIAL	Cu.	METER	CONNECTED
Storm Conne	ction:	!	SłZE		MATERIAL		INV.	CONNECTED
Cash Receipt	No's:	WAT	ER		SANITARY			STORM
CURB FROM PRO	DPERTY L	INE					PAVEMEN	T WIDTH
B.C. HYDRO					UNDERGRO	JND CONNE	ECTION	
B.C. TELEPHONE	.C. TELEPHONE UNDERGROUND CONNECTION							
INLAND GAS		•						
Information S	heets:							
Comments: THE INFORMATION CONTAINED HEREIN IS FOR INTERNAL								
USE ONLY. NOT TO BE RELIED UPON UNLESS CONFIRMED BY SITE INSPECTION AND/OR INVESTIGATION.								
				O LOUNT AND	U/OR INVESTIO	SATION.		

PLAN

N.T.S.

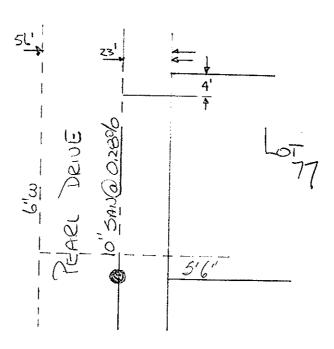

SITE