



City of Prince George  
**History Sheet**

PID:	007608721
SD/MU:	
WO:	

Civic Address: 4659 Cranbrook Hill Rd

Legal Description: Lot: A District Lot: 2609 Plan: 32199


Service Type	Diameter (mm)	Material	Invert Elev at main (m)	Invert Elev at property line (m)	Invert Elev at service end (m)	Distance into property (m)	Installation Date
Sanitary	N/A	N/A	-	-	-	-	-
Water	32mm	Plastic	-	-	-	-	1980
Storm	N/A	N/A	-	-	-	-	-

Service Connection Location			Sanitary (m)	Storm (m)
Distance from downstream San MH	-	towards upstream San MH	-	
Distance from downstream Stm MH	-	towards upstream Stm MH	-	

Power	Size	Communications	Size	Cable	Size	Gas	Size
BC Hydro	-	Telus	-	Shaw	-	FortisBC	-
Overhead Service		Overhead Service		Overhead Service			

Installed by:	Owner of Lot A and Lot B -	Survey Date:	-
Comments:	Water shutoff located in PW805 by the pressure tanks servicing Lot A and Lot B		

**NOT TO SCALE** The information contained herein is for internal use only.  
Not to be relied on unless confirmed by site inspection and/or investigation.

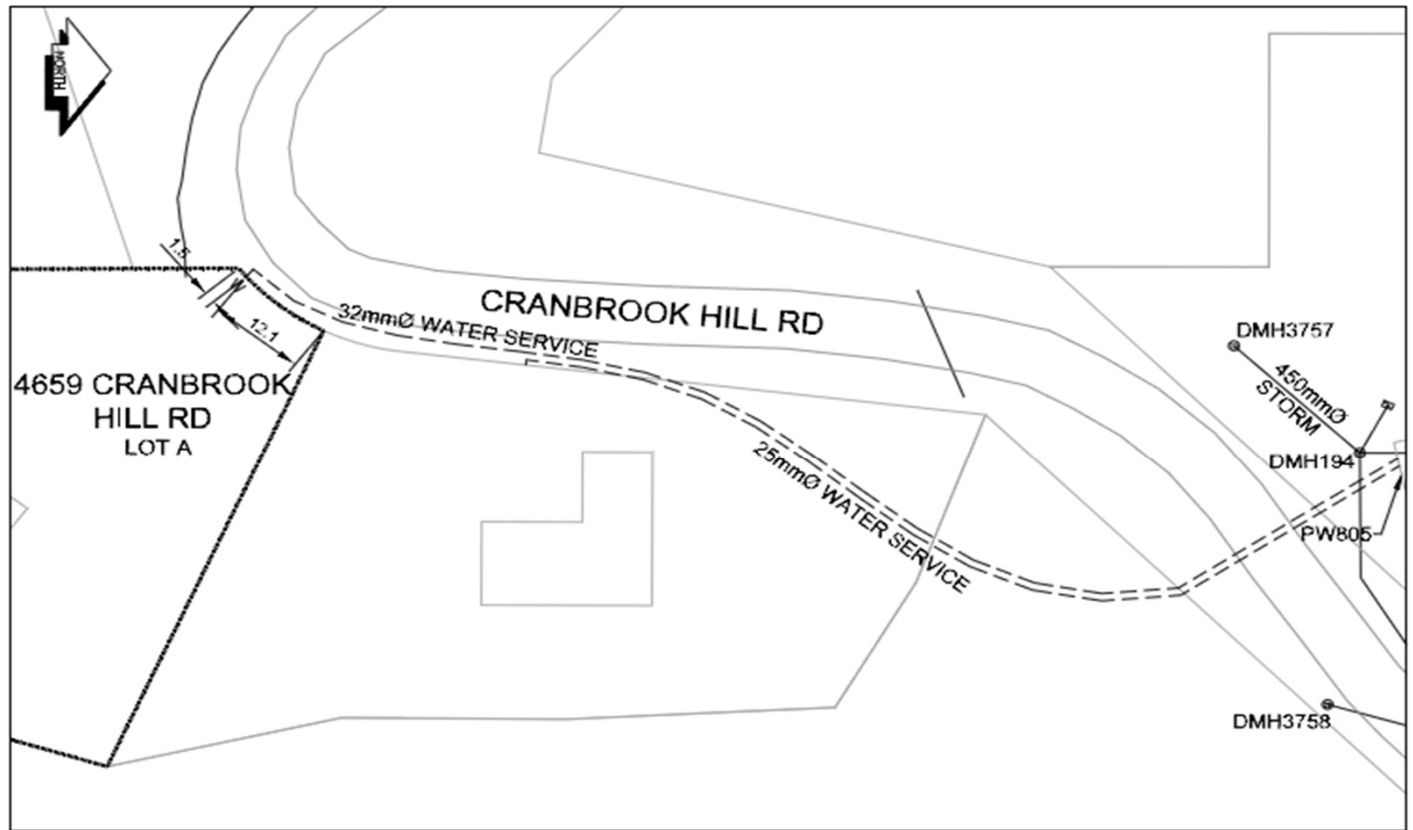

LEGEND:	CS	CURB STOP	---	WATER SERVICE	---	STORM SERVICE
	CO	CLEAN OUT	---	SANITARY SERVICE	---	WATER VALVE

**NOT TO SCALE**