

**City of Prince George
HISTORY SHEET**

009620 229
845

SHEET NUMBER _____ Roll Number _____

Legal: LOT'S 10-11 BLOCK 103 D.L. 937 PLAN 752

Address: 123 N. NICHOLSON ST.

Sanitary Connection: # 3305 SIZE 100mm MATERIAL A.C. INV. 602.043 CONNECTED

Water Connection # 3330 SIZE 20mm MATERIAL CU. METER CONNECTED

Storm Connection: # _____ SIZE _____ MATERIAL _____ INV. _____ CONNECTED

Cash Receipt No's: WATER _____ SANITARY _____ STORM _____

CURB FROM PROPERTY LINE 4.877m PAVEMENT WIDTH 10.363m


B.C. HYDRO 0/H UNDERGROUND CONNECTION

B.C. TELEPHONE 0/H UNDERGROUND CONNECTION

INLAND GAS 1.524m FROM WEST SIDE OF LANE.

Information Sheets: _____

Comments: WITH THAW WIRE.

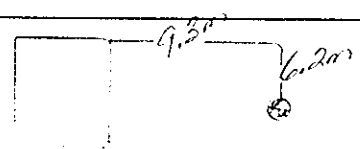

SITE PLAN N.T.S.

