



City of Prince George
History Sheet

PID:	007721552
SD/MU:	
WO:	

Civic Address: 1984 Garden Dr

Legal Description: Lot: 18 Block: 1 District Lot: 936 Plan: 10005


Service Type	Diameter (mm)	Material	Invert Elev at main (m)	Invert Elev at property line (m)	Invert Depth at service end (m)	Distance into property (m)	Installation Date
Sanitary	100mm	PVC	-	586.64	1.35	1.20	January 1964
Water	20mm	Copper	-	-	-	-	January 1963
Storm	N/A	N/A	-	-	-	-	

Service Connection Location	Sanitary (m)	Storm (m)
100mm Sanitary service connected to San MH3256	-	
Distance from downstream Stm MH - towards upstream Stm MH		

Power	Size	Communications	Size	Cable	Size	Gas	Size
BC Hydro	-	Telus	-	Shaw	-	FortisBC	-
Overhead Service		Overhead Service		Overhead Service			

Installed by:	Survey Date:	-
Comments: Water and Sanitary services as per April 27, locate		

NOT TO SCALE The information contained herein is for internal use only.
Not to be relied on unless confirmed by site inspection and/or investigation.

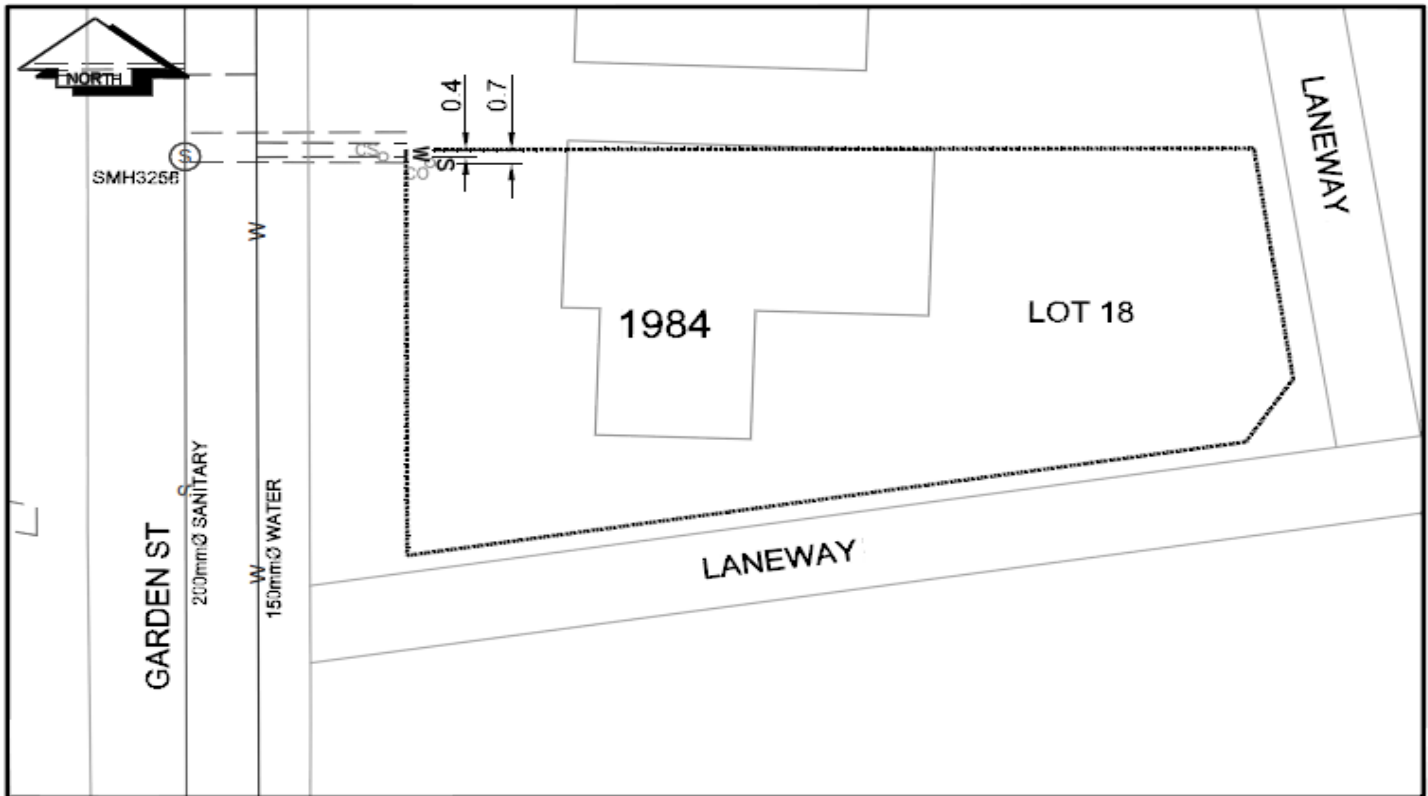

LEGEND:											
CS ^o	CURB STOP	---W---	WATER SERVICE	---S---	SANITARY SERVICE	---G---	GAS	---o---	STORM SERVICE	---	ENCUMBERANCE
CO ^o	CLEAN OUT	---	FIRE HYDRANT								
X	WATER VALVE										

NOT TO SCALE