



City of Prince George
History Sheet

PID:	007743262
	007743271
	007743408
SD:	100583
WO:	

Civic Address: 705 Carney St

Legal Description: Lot: 11 - 13 Block: 1 District Lot: 937 Plan: 752


Service Type	Diameter (mm)	Material	Invert Elev at main (m)	Invert Elev at property line (m)	Invert Depth at service end (m)	Distance into property (m)	Installation Date
Sanitary	100mm	PVC	-	586.72	1.91	-	December 1957
Water	20mm	Copper	-	-	-	-	December 1957
Storm	N/A	N/A	-	-	-	-	

Service Connection Location				Sanitary (m)	Storm (m)
Distance from downstream San MH	1969	towards upstream San MH	2668	90.29	
Distance from downstream Stm MH	-	towards upstream Stm MH	-		

Power	Size	Communications	Size	Cable	Size	Gas	Size
BC Hydro	-	Telus	-	Shaw	-	FortisBC	-
Overhead Service		Overhead Service		Overhead Service			

Installed by:	Survey Date:	-
Comments:		

NOT TO SCALE The information contained herein is for internal use only.
 Not to be relied on unless confirmed by site inspection and/or investigation.

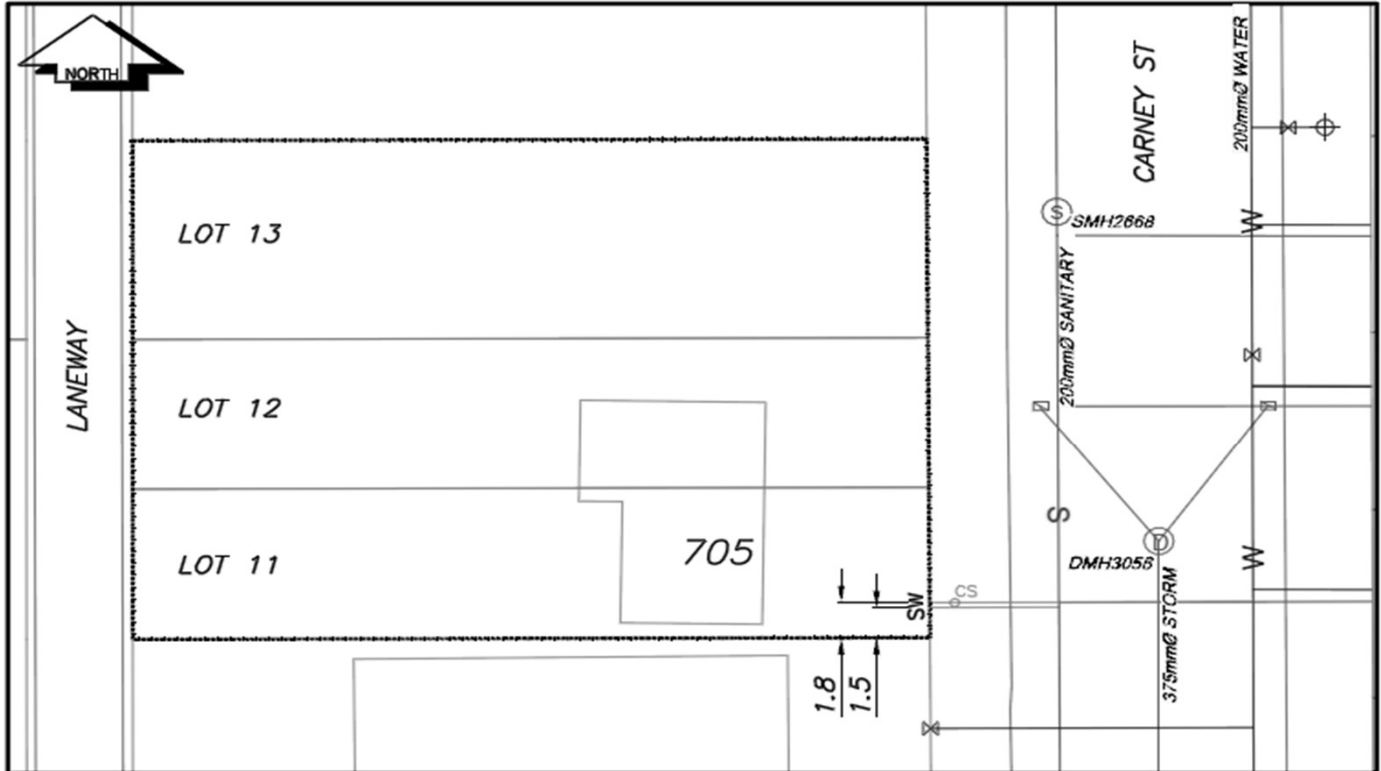

LEGEND:	
CS	CURB STOP
CO	CLEAN OUT
⊗	WATER VALVE
— W	WATER SERVICE
- - - S	SANITARY SERVICE
⊗	FIRE HYDRANT
— G	GAS
- - -	ENCUMBRANCE
—	STORM SERVICE

NOT TO SCALE