



City of Prince George History Sheet

| | |
|------|-----------|
| PID: | 007743262 |
| | 007743271 |
| | 007743408 |
| SD: | 100583 |
| WO: | |

Civic Address: 705 Carney St

Legal Description: Lot: 11 - 13 Block: 1 District Lot: 937 Plan: 752


| Service Type | Diameter (mm) | Material | Invert Elev at main (m) | Invert Elev at property line (m) | Invert Depth at service end (m) | Distance into property (m) | Installation Date |
|--------------|---------------|----------|-------------------------|----------------------------------|---------------------------------|----------------------------|-------------------|
| Sanitary | 100mm | PVC | - | 586.72 | 1.91 | - | December 1957 |
| Water | 20mm | Copper | - | - | - | - | December 1957 |
| Storm | N/A | N/A | - | - | - | - | |

| Service Connection Location | | | | Sanitary (m) | Storm (m) |
|---------------------------------|------|-------------------------|------|--------------|-----------|
| Distance from downstream San MH | 1969 | towards upstream San MH | 2668 | 90.29 | |
| Distance from downstream Stm MH | - | towards upstream Stm MH | - | | |

| Power | Size | Communications | Size | Cable | Size | Gas | Size |
|------------------|------|------------------|------|------------------|------|----------|------|
| BC Hydro | - | Telus | - | Shaw | - | FortisBC | - |
| Overhead Service | | Overhead Service | | Overhead Service | | | |

| | | |
|---------------|--------------|---|
| Installed by: | Survey Date: | - |
| Comments: | | |
| | | |
| | | |

NOT TO SCALE The information contained herein is for internal use only.
Not to be relied on unless confirmed by site inspection and/or investigation.

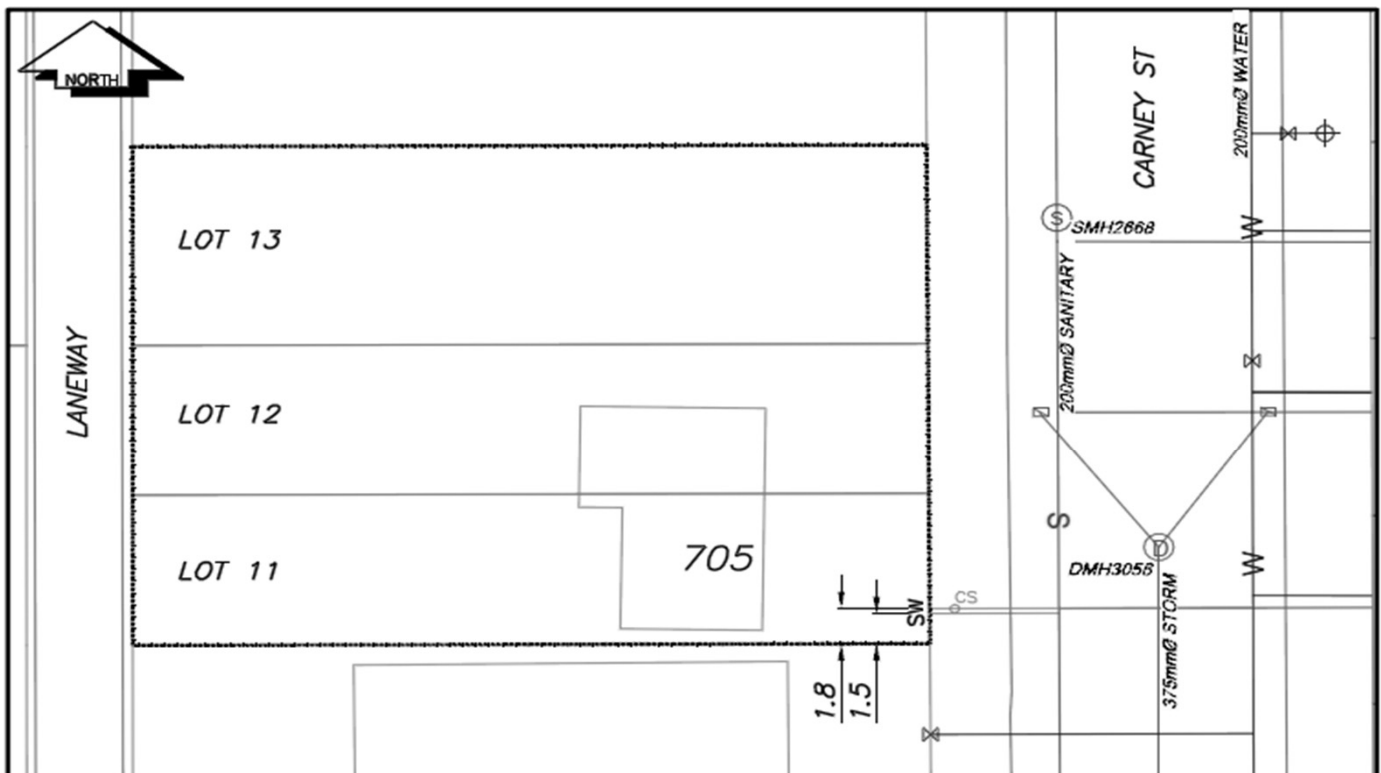

| | | | | | | | |
|----|-------------|---------|---------------|---|------------------|---|-----|
| CS | CURB STOP | W | WATER SERVICE | S | SANITARY SERVICE | G | GAS |
| CO | CLEAN OUT | - - - - | ENCUMBRANCE | | | | |
| ⊗ | WATER VALVE | ⊗ | FIRE HYDRANT | | | | |

NOT TO SCALE