


Lot Servicing

4193 ESTAVILLA DR
Lot: 2, Plan: 25305, DL: 2433

PID: 007754205

SERVICE	SIZE	MATERIAL	INSTALLED DATE	LOCATION	DETAILS
WATER	25MM	UNKNOWN	03-Oct-1979	FR NE COR BLD 90.0M N 6.9M E	CASH RECEIPT NUMBER 2276
SANITARY	100MM	PVC	09-Sep-1985	2.0M W OF NE COR PL	CONNECTION # 12428

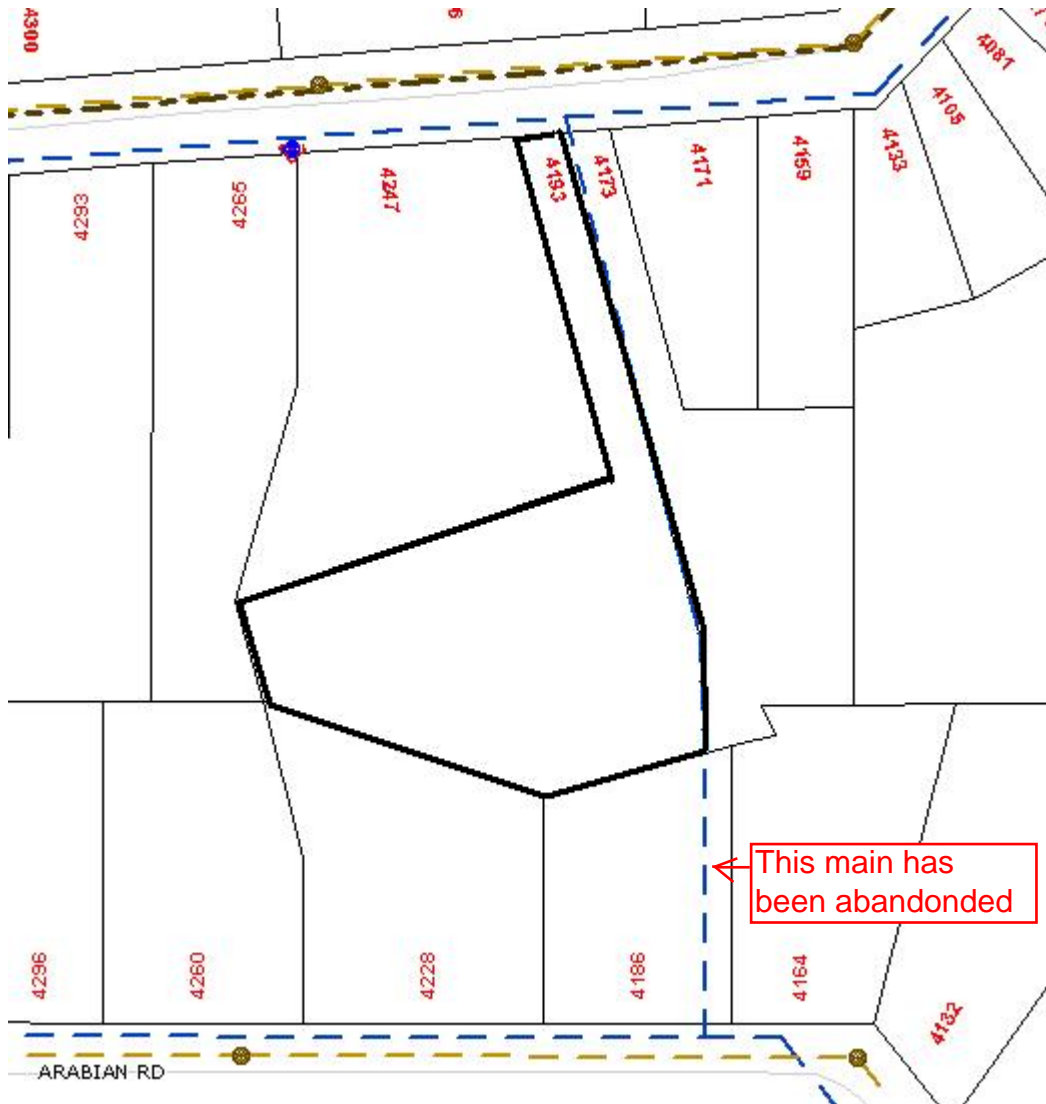

Accuracy not guaranteed unless confirmed by site inspection and/or investigation.
Connection location between main and property line only.

UNREGISTERED ROW FOR WATER ON PROPERTY