

City of Prince George HISTORY SHEET

SHEET NUMBER **3385** Roll Number **007763794**

Legal: LOT'S **B** BLOCK D.L. **8169** PLAN **25352**

Address: **366' OPIE CRES.**

Sanitary Connection: # **12684** SIZE **4"** MATERIAL **PVC** INV. **CONNECTED**

Water Connection # **12684** SIZE **1"** MATERIAL **K** METER **CONNECTED**

Storm Connection: # **1244** SIZE **6"** MATERIAL **PVC** INV. **CONNECTED**

Cash Receipt No's: WATER **2247** SANITARY **2246** STORM **2248**

CURB FROM PROPERTY LINE **4.6M** PAVEMENT WIDTH **11M**


B.C. HYDRO **OH** UNDERGROUND CONNECTION

B.C. TELEPHONE **OH** UNDERGROUND CONNECTION

INLAND GAS **AS SHOWN.**

Information Sheets:

Comments: **THE INFORMATION CONTAINED HEREIN IS FOR INTERNAL USE ONLY. NOT TO BE RELIED UPON UNLESS CONFIRMED BY SITE INSPECTION AND/OR INVESTIGATION.**

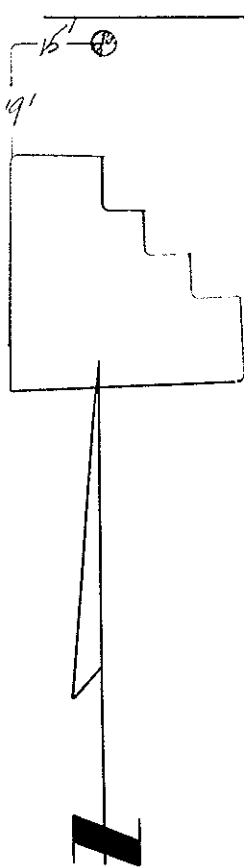

SITE PLAN N.T.S.

