

City of Prince George HISTORY SHEET

2291
927

SHEET NUMBER **Nº 2291** Roll Number

Legal: LOT'S **17-18** BLOCK **6** D.L. **937** PLAN **752**

Address: **738 IRWIN STREET**

Sanitary Connection: # **1567** SIZE MATERIAL INV. CONNECTED

Water Connection # **952** SIZE **19mm** MATERIAL **CJ** METER CONNECTED

Storm Connection: # SIZE MATERIAL INV. CONNECTED

Cash Receipt No's: WATER SANITARY STORM

CURB FROM PROPERTY LINE **4.877m** PAVEMENT WIDTH


B.C. HYDRO **OVERHEAD** UNDERGROUND CONNECTION

B.C. TELEPHONE **OVERHEAD** UNDERGROUND CONNECTION


INLAND GAS

Information Sheets:

Comments:

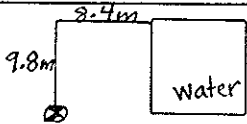

SITE PLAN N.T.S.

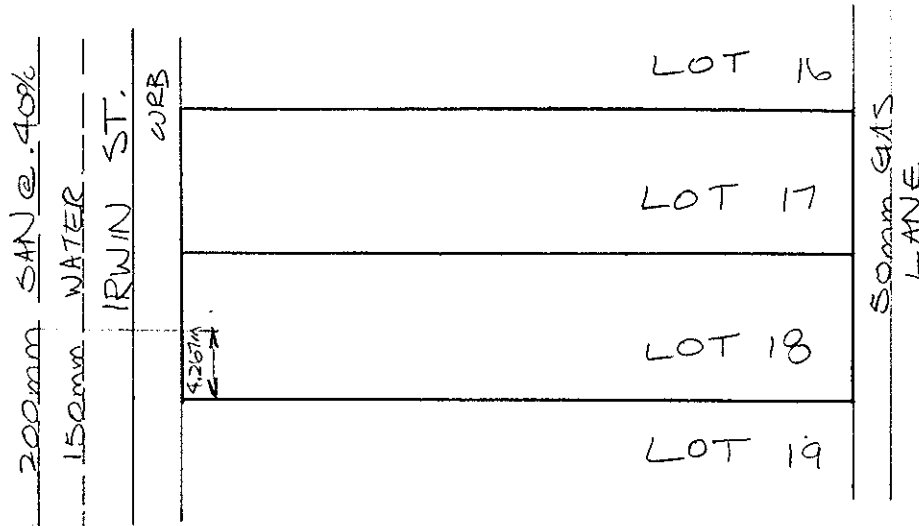

007746919


REPORT TO RECORDS

WATER SERVICE INFORMATION

Lot No. _____ Block _____ D.L. _____

Address 738 IrwinSize of Connection ☐ 1/2" ☐ 3/4" ☐ Other _____Type of Connection ☐ Copper ☐ IronThaw Wire ☐ Yes ☐ No

LOCATION SKETCH

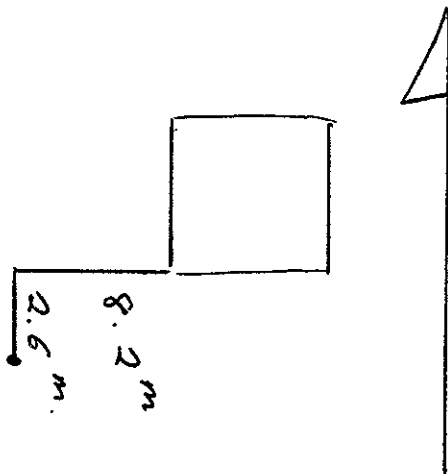Field Location By GC Date 6/8/92

Checked by: _____