



City of Prince George HISTORY SHEET

00-740917
927

SHEET NUMBER		No 2291		Roll Number	
Legal:	LOT'S	17-18	BLOCK	6	D.L. 937 PLAN 757
Address: 738 IRWIN STREET					
Sanitary Connection:	#	1567	SIZE	MATERIAL	INV. CONNECTED
Water Connection	#	952	SIZE 19mm	MATERIAL CU	METER CONNECTED
Storm Connection:	#		SIZE	MATERIAL	INV. CONNECTED
Cash Receipt No's: WATER SANITARY STORM					
CURB FROM PROPERTY LINE			9.87m PAVEMENT WIDTH		
B.C. HYDRO		OVERHEAD		UNDERGROUND CONNECTION	
B.C. TELEPHONE		OVERHEAD		UNDERGROUND CONNECTION	
INLAND GAS					
Information Sheets:					
Comments:					

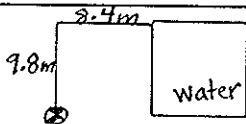

SITE PLAN N.T.S.

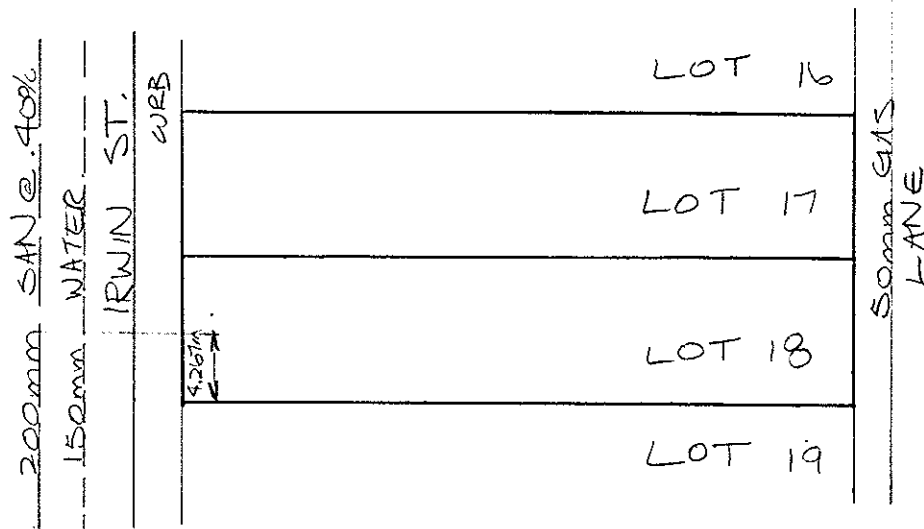

007746919


REPORT TO RECORDS

WATER SERVICE INFORMATION

Lot No. _____ Block _____ D.L. _____

Address 738 IrwinSize of Connection ☐ 1/2" ☐ 3/4" ☐ Other _____Type of Connection ☐ Copper ☐ IronThaw Wire ☐ Yes ☐ No

LOCATION SKETCH

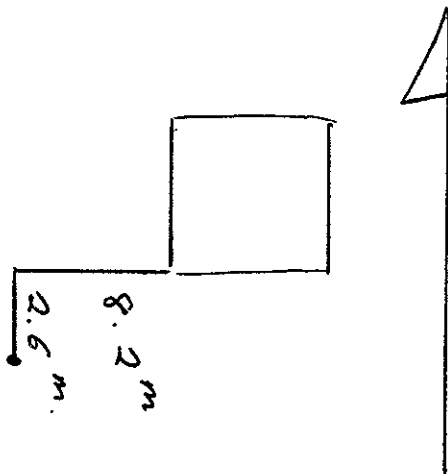Field Location By GC Date 6/8/92

Checked by: _____